NEW YORK STATE THRUWAY AUTHORITY DEPARTMENT OF ENGINEERING

ALBANY, NY JANUARY 5, 2024

AMENDMENT NO. 1 TO

CONTRACT TAS 24-5B D214950 REHABILITATION OF THE I-90 EB & I-90 WB BRIDGES OVER STERLING CREEK AT MILEPOSTS 227.40 AND 227.41 IN THE SYRACUSE DIVISION OF THE NEW YORK STATE THRUWAY IN HERKIMER COUNTY

IN THE LETTING OF JANUARY 10, 2024

NOTE: This amendment shall be attached to and become a part of the Proposal for Contract TAS 24-5B.

NOTICE

Questions and Answers for this project are available from the Authority's website, specifically at: <u>http://www.thruway.ny.gov/netdata/contractors/documents/d214950_tas24-5b_questions-and-answers-01-05-</u> <u>2024.pdf.</u> This document may be updated periodically without formal issuance of an Amendment. Prospective bidders are advised to revisit this link weekly and before proposals are due, for any possible additional questions and answers information.

Additional Supplemental Information for this project is now available from the Authority's website, specifically at: <u>http://www.thruway.ny.gov/netdata/contractors/documents/d214950_tas24-5b_supplemental-information-01-05-2024.zip</u>

The revised quantity workups to reflect the changes as mentioned below are now available and are being provided as <u>additional</u> supplemental information.

PROPOSAL

<u>Contract</u> <u>Proposal</u> <u>Page</u>	<u>Item No.</u>	Description	<u>Unit</u>	<u>Initial</u> Estimated Quantity	<u>Revised</u> <u>Estimated</u> Quantity
163	203.02	Unclassified Excavation and Disposal	CY	3,620	5,450
163	203.03	Embankment in Place	CY	415	1,360
164	404.000011	Plant Production Quality Adjustment to Asphalt Items	QU	80	87

1. <u>CHANGE</u> the estimated quantity for the following Item:

<u>Contract</u> <u>Proposal</u> <u>Page</u>	<u>Item No.</u>	<u>Unit</u>	<u>Initial</u> <u>Estimated</u> Quantity	<u>Revised</u> <u>Estimated</u> Quantity	
167	603.051116	Corrugated Steel Pipe (2-2/3 Inch X 1/2 Inch) - 15 Inch, 16 Gauge	LF	104	164
167	603.171116	Galvanized Steel End Section - Pipe (2-2/3 Inch X 1/2 Inch Corrugations) - 15 Inch Diameter, 18 Gauge	EA	4	6
172	627.5014 08	Cutting Pavement	LF	250	2,800

The Bidder shall <u>CROSS OUT</u> the estimated quantity shown for these items in the Contract Proposal, <u>WRITE IN</u> the revised estimated quantity, and submit its bid based on the noted changes. If the Bidder fails to make these changes, the Authority will do so and adjust the BID AMOUNT for the items and TOTAL BID accordingly.

2. <u>ADD</u> the following Item:

Contract Proposal Page	<u>Item No.</u>	Description	<u>Unit</u>	Estimated Quantity
173A-A1	404.017901	True and Leveling F9, Asphalt, 70 Series Compaction	TON	140

The Bidder must **<u>RETURN THE ATTACHED PAGE 173A-A1</u>** with its bid for this Contract.

PLANS

3. <u>DELETE</u> Drawing Number TYP-2, Sheet 38 of 87, and <u>REPLACE</u> with Drawing Number TYP-2, Sheet 38-A1 of 87.

• Reference to Item 404.017901 was added and other items not previously shown in the details were removed from the Items Table.

• A Median Restoration Detail for the proposed temporary paved median has been provided in the bottom middle of the plan sheet.

4. <u>DELETE</u> Drawing Number GP-1, Sheet 43 of 87, and <u>REPLACE</u> with Drawing Number GP-1, Sheet 43-A1 of 87.

• New Notes 4 and 5 have been added. The limits and intent of proposed work has been clarified and applicable pay items have been identified. Reference is made to the Median Restoration Detail as provided in amended Drawing Number TYP-2, Sheet 38-A1 of 87, attached herein.

5. <u>DELETE</u> Drawing Number GP-2, Sheet 44 of 87, and <u>REPLACE</u> with Drawing Number GP-2, Sheet 44-A1 of 87.

• New Note 5 has been added. Reference is made to the Median Restoration Detail as provided in amended Drawing Number TYP-2, Sheet 38-A1 of 87, attached herein.

6. <u>DELETE</u> Drawing Number GP-3, Sheet 45 of 87, and <u>REPLACE</u> with Drawing Number GP-3, Sheet 45-A1 of 87.

• New Note 4 has been added. Reference is made to the Median Restoration Detail as provided in amended Drawing Number TYP-2, Sheet 38-A1 of 87, attached herein.

7. <u>DELETE</u> Drawing Number ST-41, Sheet 86 of 86, and <u>REPLACE</u> with Drawing Number ST-41, Sheet 86-A1 of 87.

• All rebar used on this contract shall be galvanized. Any previous mention of epoxy was removed and changed to galvanized.

• Eastbound End Abutment for Placement 3 was reorganized (grouped together), but the subtotals for galvanized bars remain the same.

8. <u>DELETE</u> Drawing Number ST-42, Sheet 87 of 87, and <u>REPLACE</u> with Drawing Number ST-42, Sheet 87-A1 of 87.

• All rebar used on this contract shall be galvanized. Any previous mention of epoxy was removed and change to galvanized.

• Westbound End Abutment for Placement 3 was reorganized (grouped together), but the subtotals for galvanized bars remain the same.


The Bidder <u>MUST</u> complete Page <u>188</u> of the Proposal acknowledging receipt of this amendment. If the Bidder fails to complete the "Amendment Acknowledgement" sheet, his bid could be declared informal thereby delaying award of the contract.

PLEASE BE GOVERNED ACCORDINGLY WHEN SUBMITTING BIDS.

Richard W. Lee, P.E. Chief Engineer


173A-A1

NEW	YORK Thruway				01/0	04/2024 3:4	7:16 PM
STATE			AASHTOWa	re Projec	t™ Versio	n 5.00 Revi	sion 031
		Proposal Sc	chedule of Items				
Proposal I	D: D214950		Project(s):	S53075			
Contract	or:				_		
SECTION	: 0001 SECTI	ON 1					
Alt Set ID	:	Alt Mbr ID:					
Proposal Line	Item ID		Approximate	Unit F	Price	Bid An	nount
Number	Description		Quantity and Units	Dollars	Cents	Dollars	Cents
0300	404.017901		140.000				
	TRUING AND LEVELING F 70 SERIES COMPACTION	9, ASPHALT,	TON		·		

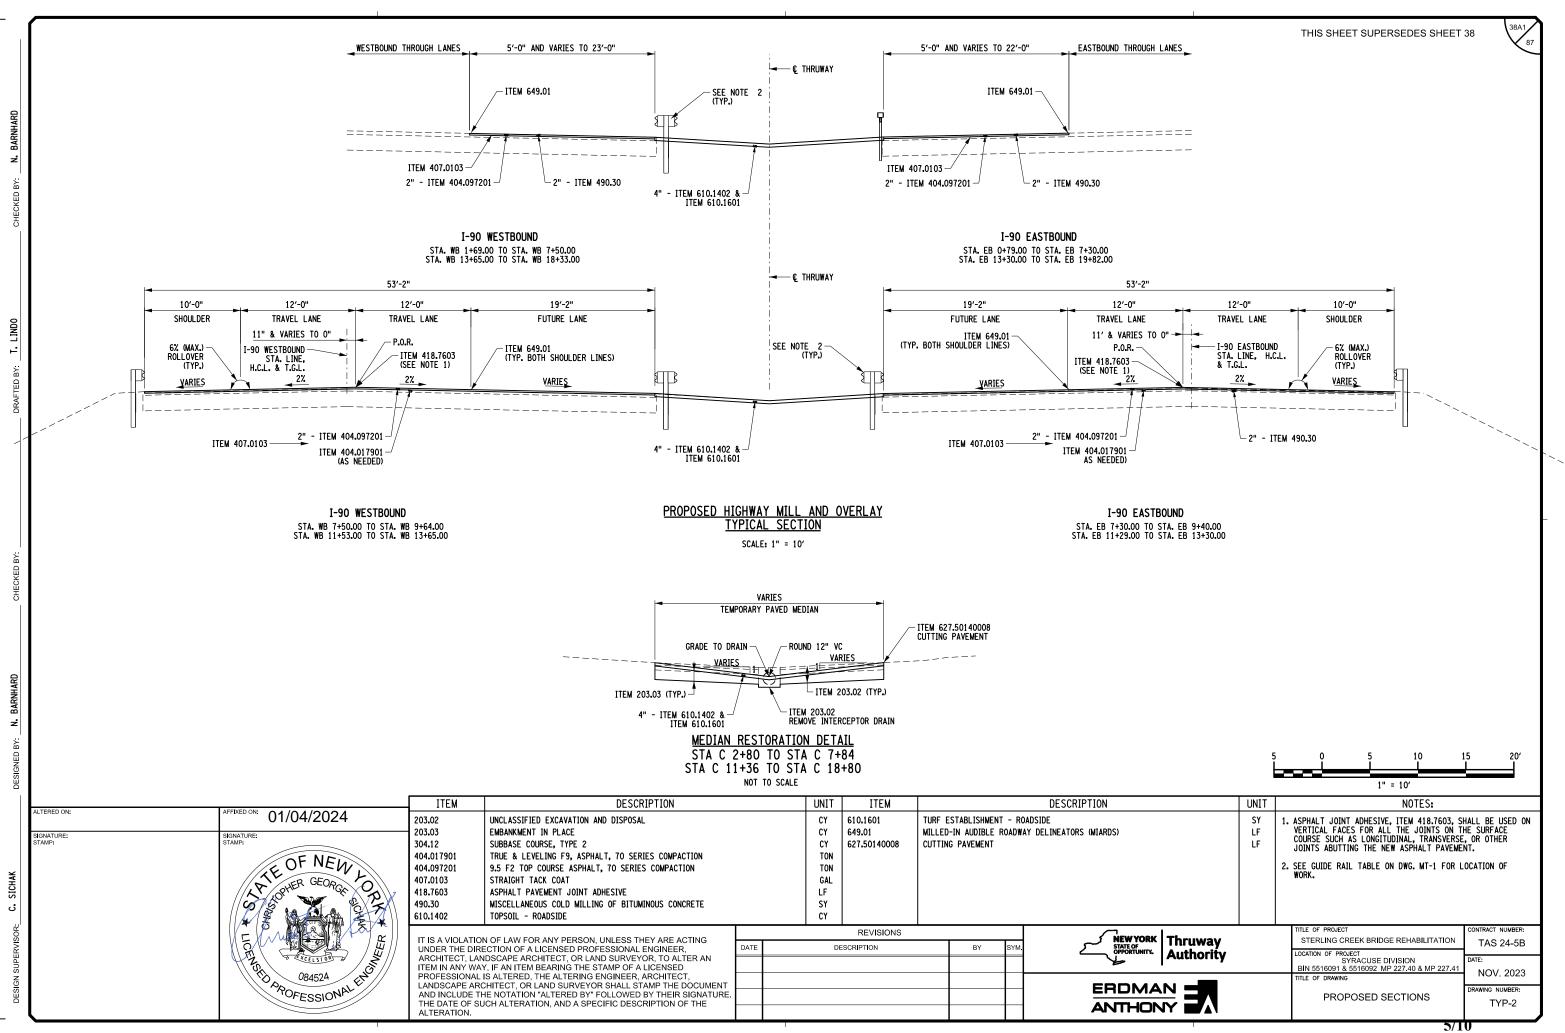

FILE NAME = B2221_cph_sec_typ2 Al.dgn DATE/TIME = 04-JAN-2024 USER = SichakC


14:07

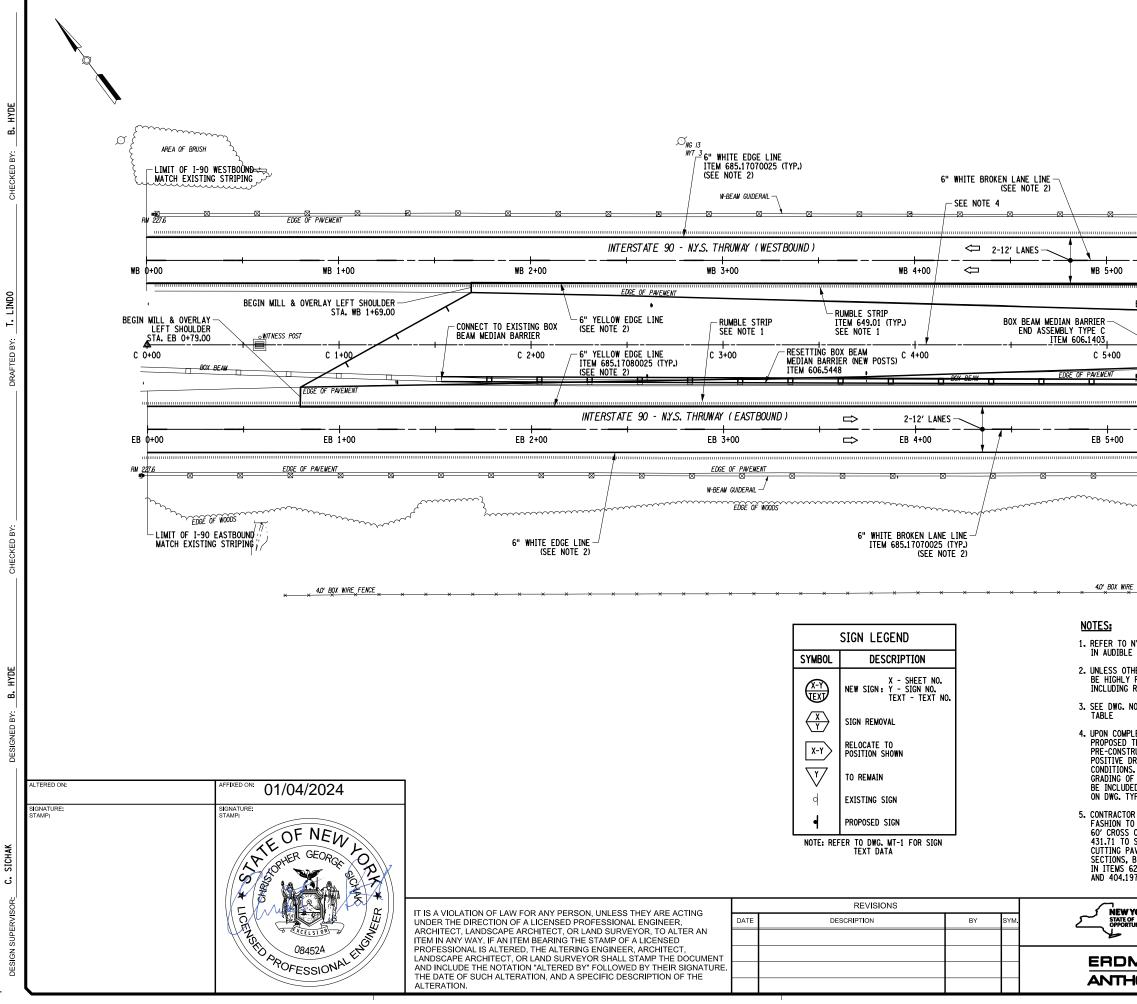

+

14:07 FILE NAME = B2221_cph_pmp_Al.dgn DATE/TIME = 04-JAN-2024 + USER = SichakC

	THIS SHEET SUPERSEDES SHEET	43 43A1 87
G		
. ^{су} нд 14 NYT 14		1
<u> </u>		E 4 ⊠
	- _	WB T
HPBO (MOD) CORRIGATED BEAM ME BARRIER END TERMINAL (ENERGY-ABSORB	DIAN — (ING)	-2
SEE NOTE 5	6.28 EDGE OF PAVEMEN	MATCH TO DRAWING NO GP-2
	6+00 × 100 × 100	
	G HEAVY POST BLOCKED-OUT (MOD.) SEAM MEDIAN BARRIER (NEW POSTS) ITEM 606,581001	TO DR.
		ATCH .
	B 6+00	≤ EB
X+X	EDGE OF PAVEMU	
~~~~~~~~~~~~~~~~~~~~~~~~~~~~~~~~~~~~~~	EDGE OF WOODS	~~~~
	ELLE U HOUSE	
FENCE × × × × ×	<del>* * * * * * * *</del>	×
NYSDOT STANDARD SHEET 649-02 FOR DE ROADWAY DELINEARS (MIARDS).	TAILS OF MILLED	I
HERWISE NOTED, ALL MAINLINE PAVEMENT REFLECTORIZED TRIPLE DROP EPOXY PAV	MARKINGS SHALL FMENT STRIPES.	
RIGHT AND LEFT EDGE LINES & BROKEN 0. MT-1 FOR GUIDERAIL TABLE & REFERE	LANE LINES.	
ETION OF CONSTRUCTION, CONTRACTOR S	HALL REMOVE	
TEMPORARY MEDIAN PAVING AND RE-ESTAB RUCTION GRASS MEDIAN, CONTRACTOR SHA RAINAGE IN ACCORDANCE WITH PRE-CONST COST OF DEMONSTRATION OF THEODOLOGY	LL ENSURE RUCTION	
. COST OF REMOVAL OF TEMPORARY MEDI MEDIAN, AND ESTABLISHMENT OF TOPSO D IN ITEMS 203.02, 610.1402 AND 610.1 P-2 A1.	IL AND THRE TO	
P-2 AI. R TO MILL AND OVERLAY U-TURN AREA IN DETAILS ON DWG. TYP-2 AI. CONTRACT(		
CULVERT PIPE FROM STA C 5+58, 1.4' L STA C 6+18, 0.1' RIGHT, INV. ELEV. 431 VEMENT. EXCAVATION. CORRUGATED STEEL	EFT, INV. ELEV. .62. COST OF . PIPE. END	
BACKFILL AND SUBBASE, AND BINDER SHA 27.50140008, 203.02, 603.051116, 603.1 7901.	LL BE INCLUDED	
	TITLE OF PROJECT	CONTRACT NUMBER:
NTT Authority	STERLING CREEK BRIDGE REHABILITATION	TAS 24-5B
	BIN 5516091 & 5516092 MP 227.40 & MP 227.41 TITLE OF DRAWING	NOV. 2023 DRAWING NUMBER:
	GENERAL PLAN	GP-1
I	6/1	<b></b>

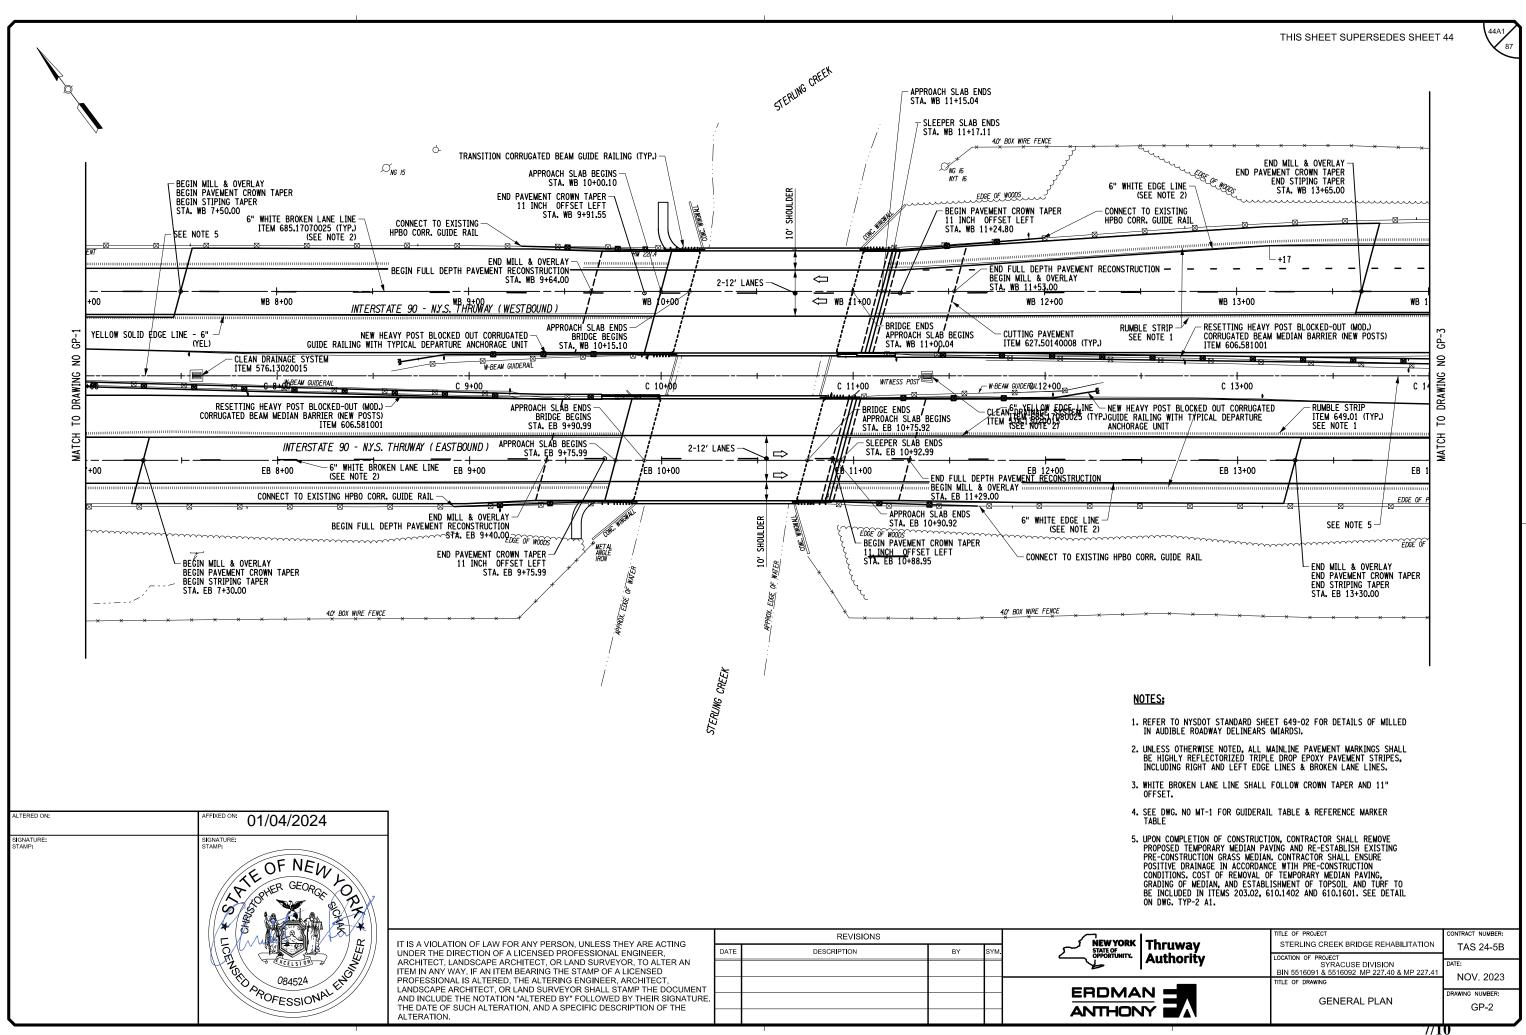

SICH


്

14:07

ę AI.

= B2221_cph_pmp_/ = 04-JAN-2024 = SichakC

FILE NAME DATE/TIME USER

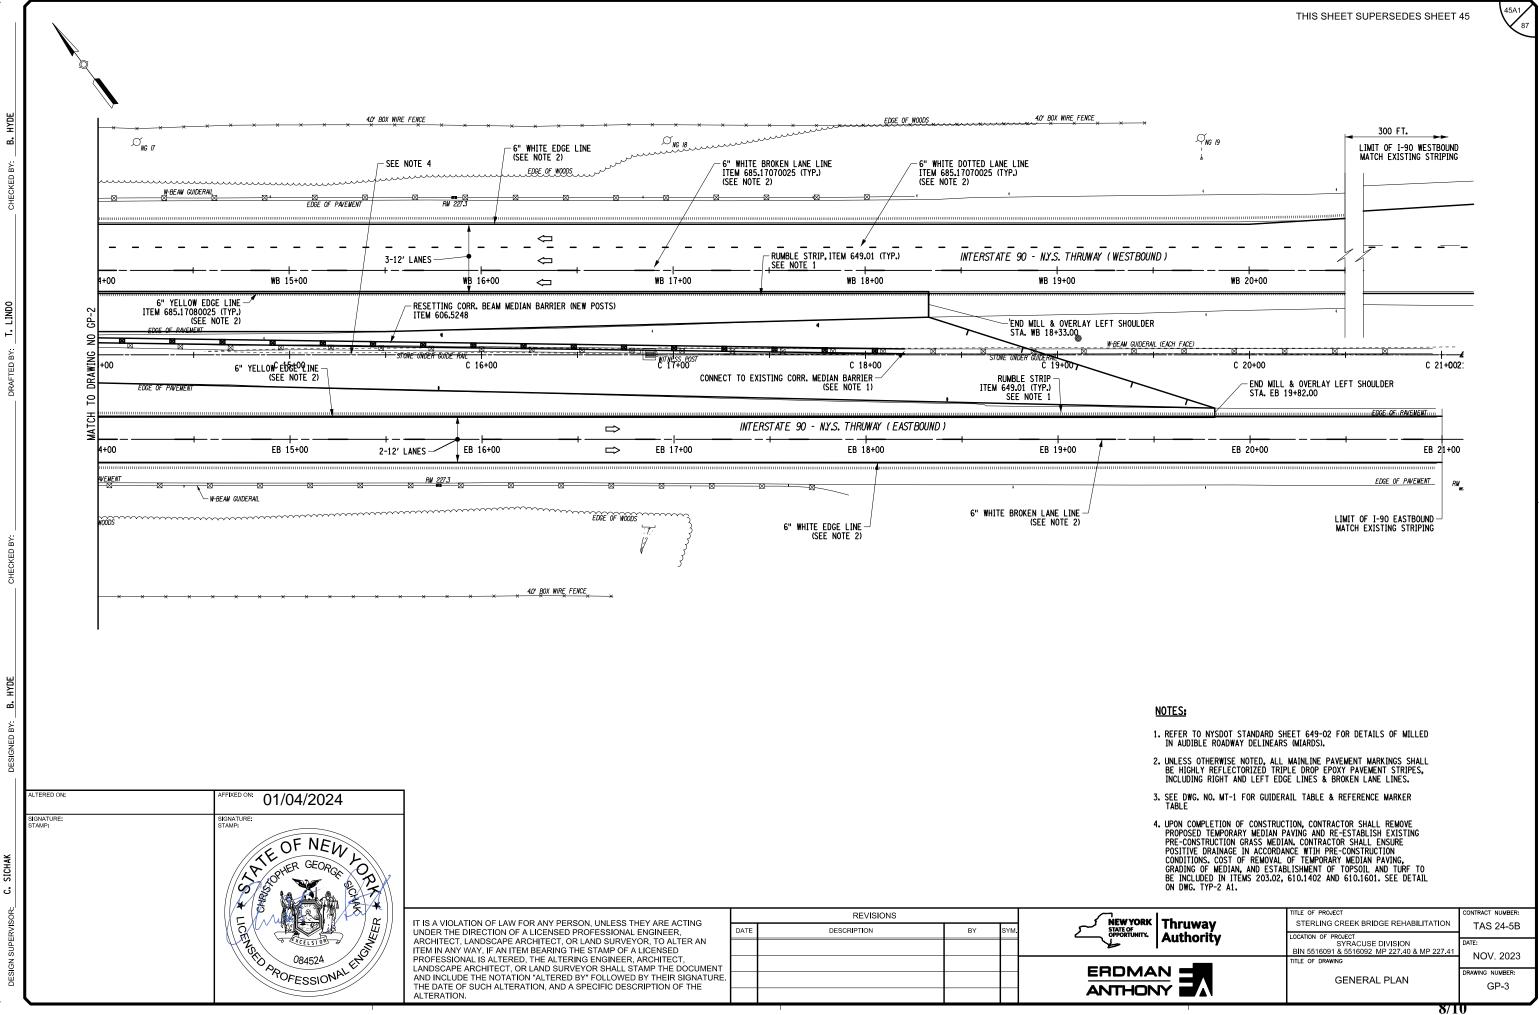

14:08 = B2221.cph.pmp.A1.dgn = 04-JAN-2024 = SichakC

FILE NAME DATE/TIME USER

_		
×/		
(1)		•
<b>U</b>	-	•

MARK NO. LENGT		Α	в	с	D	E	F	G	H H1	H2	J	К К1	К2	L	O R															THIS	SHEET	SUPER	SEDES S	HEET 86	58
EASTBOUND BEGIN ABUTMENT																				WEIGHT	A	В	С	D	E	F	G	H H1	H2	J	к К1	К2	L	ο	R
AVG.	16 285.4	0' - 0"	0' - 0"	AVG. 4' - 5 1/2"	2' - 9"				1' - 9"			1' - 9"				PLACEMEN																			
		' - 1 3/4'	TO	4' - 9"											AVG.	5AG12 5AG13		2' - 4 1/4" 2' - 5 3/4"	17				1' - 10 1/4" 1' - 11 3/4"												
LENGTH (			TO	6' - 7"	01.01									6'	' - 3 1/2"	5AG14 5AG15		2' - 7 1/2" 2' - 9"	17	21.9 22.9			2' - 1 1/2" 2' - 3"												
	17 273.0 N1 888.2		2' - 1"	2' - 1 1/2"	2' - 8"									55	5' - 5 1/4"	5AG16 5AG17	8	2' - 10 1/4" 2' - 9 3/4"	17			0' - 6"	2' - 4 1/4" 2' - 3 3/4"	0' - 0"											
SUBTOTAL GALVANIZED BARS	1695.9 LE	BS THIS POL	UR													5AG18 5AG19	8	2' - 8 1/4" 2' - 5 3/4"	17	22.4 20.7		0' - 6"	2' - 2 1/4" 1' - 11 3/4"	0' - 0"			0. 5 4 0.								
PLACEMENT 2																SUBTOTAL		10' - 0"	11		0' - 5 1/2' LBS THIS		1' - 11 1/2"	2' - 1"	1' - 11 1/2"		0' - 5 1/2"	0" - 3 3/4"							
5AG05 8 59' - 2" 5AG06 41 3' - 2"	N1 493.7 17 135.4		1' - 0"	1' - 2"	1' - 0"										59' - 2"	EASTBOUN			- SLAB	332.1															
5AG07         4         5' - 10 1/4"           5AG08         4         4' - 7 3/4"	N12 19.4			3' - 1 1/4" 1' - 10 3/4"					0' - 9 3/4" 0' - 6"			3' - 0" 1' - 10"				4SG01		57' - 9 3/4"		5097.9														57' - 9 3/4"	
5AG11 6 6' - 7"	N1 41.1														6' - 7"	4SG02 4SG03		60' - 0" 26' - 4 1/4"		6412.8 2815.9														60' - 0" 26' - 4 1/4"	
SUBTOTAL GALVANIZED BARS	714.1 LE		UR													5SG04 5SG05	12	60' - 0" 28' - 3 1/4"	N1															60' - 0" 28' - 3 1/4"	
PLACEMENT 3 5AG12 8 2' - 4 1/4"	17 19.6		0' 6"	1' - 10 1/4"	0' 0"											4SG06 4SG07	132	51' - 3 1/2"	1	4522.7	0' - 6" 0' - 6" {	50' - 9 1/2"					0' - 0"			0' - 4"					
5AG12         6         2         4         1/4           5AG13         8         2' - 5         3/4"           5AG14         8         2' - 7         1/2"	17 13.0 17 20.8 17 21.9		0' - 6"	1' - 11 3/4" 2' - 1 1/2"	0' - 0"											6SG08 5SG09	242	2' - 10"	N1	715.2	0' - 8"		01 01				0' - 0"		01.01	0' - 6"	0.04/4	01 01		2' - 10"	
5AG15         8         2' - 9"           5AG16         8         2' - 10 1/4"	17 22.9 17 23.8		0' - 6"	2' - 3" 2' - 4 1/4"	0' - 0"											6SG10 6SG11		4' - 5" AVG. 4' - 5"		424.6	1' - 0"	AVG.		0' - 0"				AVG.	0' - 0"		0' - 2 1/4" AVG. 0' - 1"	0' - 0"		3' - 7 1/4" AVG. 3' - 6"	
5AG17         8         2' - 9 3/4"           5AG18         8         2' - 8 1/4"	17 23.5 17 22.4		0' - 6"	2' - 3 3/4" 2' - 2 1/4"	0' - 0"													4 - 5 LENGTH H LENGTH K	VARIES FF	ROM	0' - 11 3/4" 0' - 0"	TO		0-0				0 - 11 3/4	0-0		v - 1	0-0		0-0	
5AG19 8 2' - 5 3/4" 5AG20 15 10' - 0"	17 20.7 T1 156.5 0			1' - 11 3/4" 1' - 11 1/2"	0' - 0" 2' - 7"	1' - 11 1/2"	(	0' - 5 1/2"	0' - 3 3/4"							7SG12 5SG13	20	5' - 8 3/4" 6' - 5 1/2"	14	-	2' - 8 1/2'			0' - 0"	0' - 0"			0' - 4 1/2" 2' - 10"	0' - 0"		0' - 4 1/2"	0' - 0"		0' - 6"	
SUBTOTAL GALVANIZED BARS	332.1 LE	BS THIS POL	UR													5SG14 4SG15		3' - 8 1/2" 7' - 0"	1		0' - 7" 0' - 6"						0' - 6"			0' - 5" 0' - 4"					
ASTBOUND END ABUTMENT																4SG16 4SG17		3' - 5 1/4" 3' - 2 1/2"	16 N8	18.4 30.0				2' - 0 1/4" 1' - 0 1/2"	0' - 4"	0' - 9"		1' - 5 1/4"			1' - 5 1/4"			2' - 10 1/4" 2' - 6 1/2"	
PLACEMENT 1				AVG.												SUBTOTAL	. GALVANI	ZED BARS		26540.3	LBS THIS P	OUR													
AG01 38 7' - 9 3/4"	16 309.3 VARIES FROM	0' - 0" 4' - 9"		5' - 0 3/4"	2' - 9"				1' - 9"			1' - 9"				EASTBOUN	ND BEGIN /	APPROACH :	SLAB																
AG02 38 6' - 9 1/2"															AVG. ' - 9 1/2"	5HG01 5HG02	_	14' - 6" 54' - 2 1/4"		2510.5														14' - 6" 54' - 2 1/4"	
LENGTH (		6' - 6" 2'		7' - 1" 2' - 1 1/2"	3' - 1 3/4"											5HG03		4' - 9"		39.6		0' - 0"	0' - 0"	2' - 0"	0' - 9"	2' - 0"		1' - 5"	1' - 5"		0' - 0"	1' - 5"	0' - 0"		
	N1 888.2													55	5' - 5 1/4"	SUBTOTAL	. GALVANI	ZED BARS	_	4359.0	LBS THIS P	OUR													
	1777.6	LBS THIS F	POUR													EASTBOUN	ND END AF	PROACH SL	AB																
LACEMENT 2															501 01	5HG01 5HG02		14' - 6" 54' - 2 1/4"		1808.9														14' - 6" 54' - 2 1/4"	
AG05 8 59' - 2" AG06 41 3' - 2" AG09 4 5' - 10 1/4"	N1 493.7 17 135.4 N12 24.4		1' - 0" 0' - 0"	1' - 2" 3' - 1 1/4"	1' - 0"				0' - 9 3/4"			3' - 0"			59' - 2"	5HG03		4' - 9"	N11			0' - 0"	0' - 0"	2' - 0"	0' - 9"	2' - 0"		1' - 5"	1' - 5"		0' - 0"	1' - 5"	0' - 0"	3' - 7"	
AG09 4 5' - 10 1/4" AG10 4 4' - 7 3/4" AG11 6 7' - 1"	N12         24.4           N12         19.4           N1         44.3			1' - 10 3/4"					0' - 6"			3 - 0 1' - 10"			7' - 1"	SUBTOTAL				4359.0	LBS THIS P	OUR													
UBTOTAL GALVANIZED BARS	717.2	LBS THIS F	POUR												7 - 1	EASTBOUN 5HG11				642.5														E' C"	
				1	I		I	I	I	I	I	I	I	I		5HG12 5HG13	17	5' - 6" 54' - 2 1/4" 4' - 6"	N1 N1 17	642.5 961.0 262.8		1' 6"	1' - 6"	1' 6"										5' - 6" 54' - 2 1/4"	
																SUBTOTAL					LBS THIS P		1-0	1-0											
																EASTBOUN																			
																7BG01	24	60' - 0"	N1	2943.4														60' - 0"	
																7BG02 5BG03	178	29' - 2 1/4" 6' - 5 3/4"		1431.5 1202.9			0' - 8 3/4"	2' - 9 3/4"			0' - 0"			0' - 0"	2' - 10 1/2"		0' - 7 1/2"	29' - 2 1/4" 3' - 0 3/4"	0' - 3"
																5BG04		AVG. 6' - 5 1/4"	13			AVG. 2' - 10 1/2"		2' - 9 3/4"			0' - 0"	AVG. 0' - 9 3/4"		0' - 0"	AVG. 2' - 10"		AVG. 0' - 3 3/4"	3' - 0 3/4"	0' - 3"
D ON:	AFF	FIXED ON: (	01/04	4/202	24											50.005	20	LENGTH K	VARIES FR	OM	2' - 9 3/4' 0' - 0"	TO TO	2' - 10 1/2" 0' - 7 1/2"					21 21						0' 6"	
URE:	SIG	MATURE:														5BG05	20	5' - 1 1/2"	S11	100.8								2' - 2"						0' - 6"	
		//	101	FNF												SUBTOTAL	. GALVANI	ZED BARS		6114.2	LBS THIS P	OUR													
		* CZAY	TOPHEF NOPHEF	R GEOR	LO COM																														
		15/	M	E.	May								THEY ARE		DATE		DESCI	REVISIO RIPTION	NS		BY	SYM.		کمہ	NEW YO STATE OF OPPORTUNI	RK Th	ruway Ithorit	Y			IG CREEK E	BRIDGE RE	EHABILITAT		ract num TAS 24-
		HE	1	CELSIOR	~/	¥//	ARCHITE	ECT, LAN ANY WAY	DSCAPE AF '. IF AN ITEI	RCHITEC	T, OR LAI NG THE S	ND SURV	EYOR, TO A A LICENSE	ALTER AN										<u> </u>		""   <b>A</b> u	Itnori	<b>'Y</b>			SYRACI 91 & 55160	USE DIVIS 092 MP 227	ION 7.40 & MP 22	DATE 27.41	10V. 20
		(C)	PROF	084524	NALEN	//	PROFES	APE ARC	HITECT, OF	R LAND S	URVEYO	R SHALL	R, ARCHITE STAMP THE ED BY THEIF	E DOCUM								$\square$		E		IAN	_			TITLE OF DR	AWING	R LIST			NOV. 20
				FSSIO	·"//		THE DAT	TE OF SU					SCRIPTION									$\square$										OF 2)			ST-4

14:09

+

FILE NAME = B2221.cpb.tb1.bar2A1.dgn DATE/TIME = 04-UAN-2024 + USER = SichakC C. SICHAK DESIGN SUP

	TITLE OF PROJECT	CONTRACT NUMBER:
STATE OF STATE OF	STERLING CREEK BRIDGE REHABILITATION	TAS 24-5B
	LOCATION OF PROJECT	DATE:
	SYRACUSE DIVISION BIN 5516091 & 5516092 MP 227.40 & MP 227.41	NOV. 2023
	TITLE OF DRAWING	NOV. 2023
	BAR LIST	DRAWING NUMBER:
	(1 OF 2)	ST-41

	NO. LENGTH	TYPE WEIGH	ГА	В	с	D	E	F	G	H H1	H2	J	К К1 К2	L	0	R											·			٦	THIS SHI	EET SUP	ERSEDES	SHEET 87	87
PLACEMENT	AVG. 38 7' - 5"	16 293.9 ARIES FROM			AVG. 4' - 8" 5' - 0 1/4"					1' - 9"			1' - 9"					IND END A	. LENGT		E WEIGHT	ГА	В	с	D	E	F	G	H H1	H2	J	K K1	К2	L O	F
5AG02 5AG03	38 6' - 6"	ARIES FROM ARIES FROM 17 273.0		то	6' - 10 1/4 2' - 1 1/2"										AVG. 6' - 6"		PLACEME 5AG12 5AG13	8	2' - 9 3/4" 2' - 0"	17	23.4 25.0		0' - 6"	2' - 6"	' 0' - 0" 0' - 0"										
	6 55' - 5 1/4"	N1 888.2 1712.9	LBS THIS												55' - 5 1/4"		5AG14 5AG15 5AG16 5AG17 5AG18	8 8 8	3' - 1 1/4" 3' - 1 1/4" 2' - 11 3/4" 2' - 10" 2' - 8"	17				2' - 7 1/4 2' - 5 3/4 2' - 4"	' 0' - 0" ' 0' - 0" ' 0' - 0" 0' - 0" 0' - 0"										
PLACEMENT 2 5AG05 5AG06 5AG09	8 59' - 2" 41 3' - 2" 4 5' - 10 1/4"	N1 493.7 17 135.4 N12 24.4		1' - 0"	1' - 2" 3' - 1 1/4"	1' - 0"				0' - 9 3/4"			3' - 0"		59' - 2"		5AG19 5AG20	8 23	2' - 6" 10' - 0" IIZED BARS	17	20.9 239.9		0' - 6" 2' - 7"	2' - 0"		1' - 11 1/2	2"	0' - 5 1/2"	0' - 3 3/4"						
5AG10 5AG11	4 4' - 7 3/4" 6 6' - 8 3/4"	N12 19.4 N1 42.1	LBS THIS	0' - 0"	1' - 10 3/4					0' - 6"			1' - 10"		6' - 8 3/4"		WESTBOU 4SG01 4SG02	132	RSTRUCTUF	N1	5097.9 6412.8													57' - 9 3/	
PLACEMENT 3	8 2' - 9 3/4"	17 23.4			2' - 3 3/4"												45G02 48G03 58G04 58G05 48G06	160 12 12	60' - 0" 26' - 4 1/4" 60' - 0" 28' - 3 1/4" 7' - 6 1/2"	N1 N1 N1	2815.9 751.0 353.7	0' - 6"	7' - 0 1/2"	· · · · · · · · · · · · · · · · · · ·				0' - 0"			0' - 4"			60' - 0' 26' - 4 1/ 60' - 0' 28' - 3 1/	4"
5AG13 5AG14 5AG15 5AG16 5AG17	8 2' - 0" 8 3' - 1 1/4" 8 3' - 1 1/4" 8 2' - 11 3/4" 8 2' - 10"	17         25.0           17         25.9           17         25.9           17         24.9           17         23.7		0' - 6" 0' - 6"	2' - 6" 2' - 7 1/4" 2' - 7 1/4" 2' - 5 3/4" 2' - 4"	' 0' - 0" ' 0' - 0" ' 0' - 0"											4SG07 6SG08 5SG09 6SG10	264 242 178	51' - 3 1/2" 5' - 10 1/2" 2' - 10" 4' - 5"	1 1 N1		0' - 6" 0' - 8"	50' - 9 1/2 5' - 2 1/2" 3' - 5"					0' - 0" 0' - 0"	0' - 11 3/4"	0' - 0"	0' - 4" 0' - 6"	0' - 2 1/4"	0' - 0"	2' - 10' 3' - 7 1/4	
5AG18 5AG19 5AG20	8 2' - 8" 8 2' - 6" 23 10' - 0"	17         22.3           17         20.9           T1         239.9	0' - 5 1/2'	0' - 6" 0' - 6"	2' - 2" 2' - 0"	0' - 0" 0' - 0"	1' - 11 1/2"		0' - 5 1/2"	' 0' - 3 3/4"							6SG11	64	AVG. 4' - 5" LENGTH H LENGTH K 5' - 8 3/4"	I VARIES F		0' - 11 3/		1' - 0" 0' - 2 1/4					AVG. 0' - 11 3/4" 0' - 4 1/2"	0' - 0"		AVG. 0' - 1" 0' - 4 1/2"		AVG. 3' - 6"	_
WESTBOUND	LVANIZED BARS	431.9	LBS THIS	POUR													5SG13 5SG14 4SG15 4SG16	20 20 166	6' - 5 1/2" 3' - 8 1/2" 7' - 0" 3' - 5 1/4"	14 S11 1 1 16	134.6 77.4 776.2	0' - 7" 0' - 6"	3' - 1 1/2" 6' - 0"		2' - 0 1/4'			0' - 6"	2' - 10"		0' - 5" 0' - 4"	1' - 5 1/4"		0' - 6"	
PLACEMENT 2 5AG01		16 317.8 ARIES FROM			AVG. 5' - 3 1/4" 5' - 7 1/2"					1' - 9"			1' - 9"		AVG.			L GALVAN	3' - 2 1/2" IIZED BARS			LBS TH	0' - 9" S POUR	0' - 4"	1' - 0 1/2'	0' - 4"	0' - 9"							2' - 6 1/2	
5AG02 5AG03 8AG04	38         7' - 0"           LENGTH OV           38         7' - 10 1/4"           6         55' - 5 1/4"		6' - 7 3/4'		7' - 4 1/4" ' 2' - 1 1/2"										7' - 0"		5HG01 5HG02 5HG03	166	N APPROACH 14' - 6" 54' - 2 1/4" 4' - 9"	N1 N1	2510.5 1808.9 39.6		0' - 0"	0' 0"	2' 0"	0' 0"	2' - 0"		1' 5"	1' - 5"		0' 0"	1' - 5" 0	14' - 6' 54' - 2 1/ 0" 3' 7"	4"
SUBTOTAL GA	LVANIZED BARS	1794.7	LBS THIS	POUR													SUBTOTA	L GALVAN	IIZED BARS			LBS TH													
5AG05 5AG06 5AG07 5AG08	8 59' - 2" 41 3' - 2" 4 5' - 10 1/4" 4 4' - 7 3/4"	N1         493.7           17         135.4           N12         24.4           N12         19.4		1' - 0" 2' - 9" 2' - 9"		1' - 0" ' 0' - 0" " 0' - 0"				0' - 9 3/4" 0' - 6"			3' - 0" 1' - 10"		59' - 2"		5HG01 5HG02 5HG03	32	i 14' - 6" 54' - 2 1/4" 4' - 9"	N1	2510.5 1808.9 39.6		0' - 0"	0' - 0"	2' - 0"	0' - 9"	2' - 0"		1' - 5"	1' - 5"		0' - 0"	1' - 5" 0	14' - 6' 54' - 2 1/ - 0" 3' - 7"	_
5AG11 SUBTOTAL GA	6 7' - 2 3/4" LVANIZED BARS	N1 45.3 718.2	LBS THIS	POUR											7' - 2 3/4"				IIZED BARS		4359.0	LBS TH	S POUR												
																	5HG11 5HG12 5HG13	17 56	2 5' - 6" 54' - 2 1/4" 4' - 6"	N1	642.5 961.0 262.8		1'-6"	1' - 6"	1' - 6"									5' - 6" 54' - 2 1/	
																	WESTBOL 7BG01	INDD BAR	IIZED BARS RIER 60' - 0"		2943.4	LBS TH												60' - 0'	
FERED ON:			AFFIXED O	∾ 01/	/04/20	)24		7									7BG02 5BG03 5BG04	24 178	29' - 2 1/4" 6' - 5 3/4" AVG. 6' - 5 1/4"	N1 13 13	1431.5 1202.9 429.7		2' - 11 1/4 AVG. 2' - 10 1/2	AVG.	' 2' - 9 3/4' 2' - 9 3/4'				1' - 1 1/2" AVG. 0' - 9 3/4"		0' - 0"	2' - 10 1/2" AVG. 2' - 10"	A	29' - 2 1/ 7 1/2" 3' - 0 3/4 /G. 3 3/4" 3' - 0 3/4	4" ."
IGNATURE: TAMP:			SIGNATURI STAMP:		OF N	FIA											5BG05	20	LENGTH K LENGTH L 5' - 1 1/2"	VARIES F		2' - 9 3/4 0' - 0"	" TO TO	2' - 10 1/2 0' - 7 1/2	_				2' - 2"					0' - 6"	
			A	A E	HER GE	ORGE	ORI										SUBTOTA	L GALVAN	IIZED BARS		6114.2	LBS TH	S POUR			1			1						
				1₩ \	A CELSU		WOINEER *	UNDE ARCH	ER THE D	IRECTION	OF A LICE E ARCHIT	ENSED PR	ON, UNLESS THEY ROFESSIONAL ENG LAND SURVEYOR,	GINEER, TO ALTE		DATE	I	RE	EVISIONS ION		E	3Y 5	YM.	Ż		WYORK	Thru Auth	way ority		STE	ON OF PROJ	ECT 'RACUSE DI	E REHABILITA	TION TA	ст NUI \S 24
			LICEN	SEDAR	08452 OFESSI	4 ONAL E	<b>S</b>	PROF LAND AND THE I	ESSIONA	AL IS ALTE ARCHITEC THE NOT SUCH ALT	RED, THE T, OR LAN ATION "AL	ALTERIN D SURVE` TERED B`	E STAMP OF A LIC G ENGINEER, ARC YOR SHALL STAM Y" FOLLOWED BY PECIFIC DESCRIP	CHITECT, P THE DO THEIR SIO	GNATURE.																5516091 & OF DRAWING	BAR LIS (2 OF 2	<u>° 227.40 &amp; MP</u>	DRAWIN	DV. 2 5 NUM ST-4

14: 10 FILE NAME = B2221.cpb.tb1.bar3A1.dgn DATE/TIME = 04-JAN-2024 + USER = SichakC



UNDER THE DIRECTION OF A LICENSED PROFESSIONAL ENGINEER, ARCHITECT, LANDSCAPE ARCHITECT, OR LAND SURVEYOR, TO ALTER AN ITEM IN ANY WAY, IF AN ITEM BEARING THE STAMP OF A LICENSED PROFESSIONAL IS ALTERED, THE ALTERING ENGINEER, ARCHITECT, LANDSCAPE ARCHITECT, OR LAND SURVEYOR SHALL STAMP THE DOCUMENT AND INCLUDE THE NOTATION "ALTERED BY" FOLLOWED BY THEIR SIGNATURE. THE DATE OF SUCH ALTERATION, AND A SPECIFIC DESCRIPTION OF THE ALTERATION.

			REVISIONS		
	SYM.	BY	DESCRIPTION	DATE	
Y					
ERDM					
					Ξ.
ANTHO					

## 10/10

ORK	Thruway	TITLE OF PROJECT STERLING CREEK BRIDGE REHABILITATION	CONTRACT NUMBER: TAS 24-5B
UNITY,	Authority	LOCATION OF PROJECT	DATE:
		SYRACUSE DIVISION BIN 5516091 & 5516092 MP 227.40 & MP 227.41	NOV. 2023
		TITLE OF DRAWING	1000.2025
MA		BAR LIST	DRAWING NUMBER:
ION		(2 OF 2)	ST-42