


SECTIONAL PLAN


SECTION A 90

SLOT DETAILS

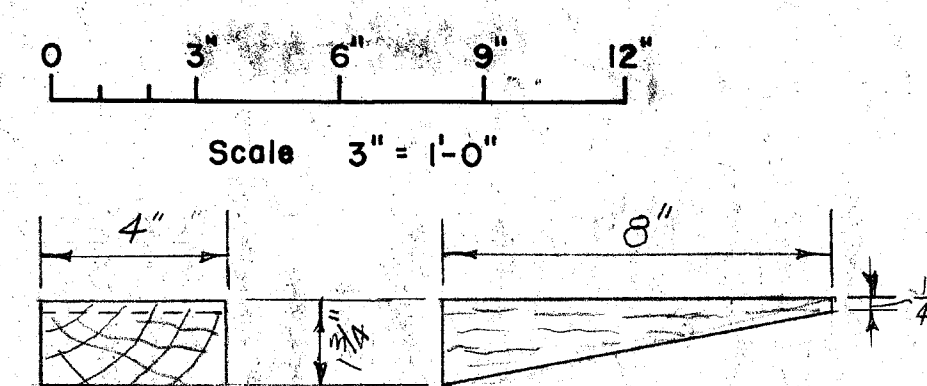


DETAIL OF HARDWOOD WEDGE

Scale 3" = 1'-0"
84 REQUIRED NO.1
260 REQUIRED NO.2

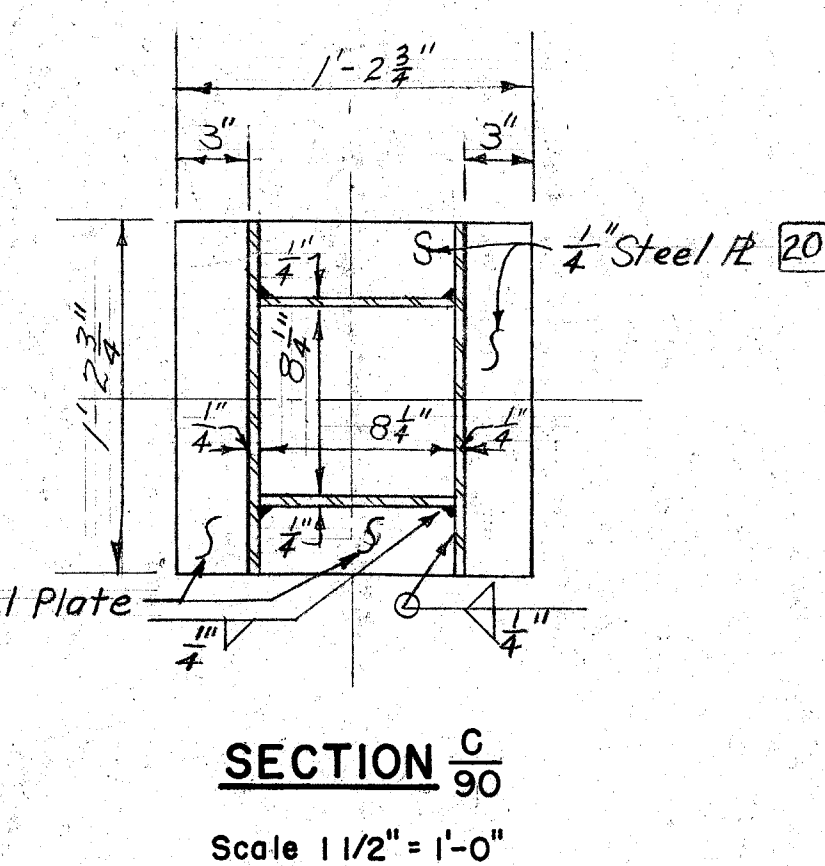


SECTION C 90

Scale 1 1/2" = 1'-0"


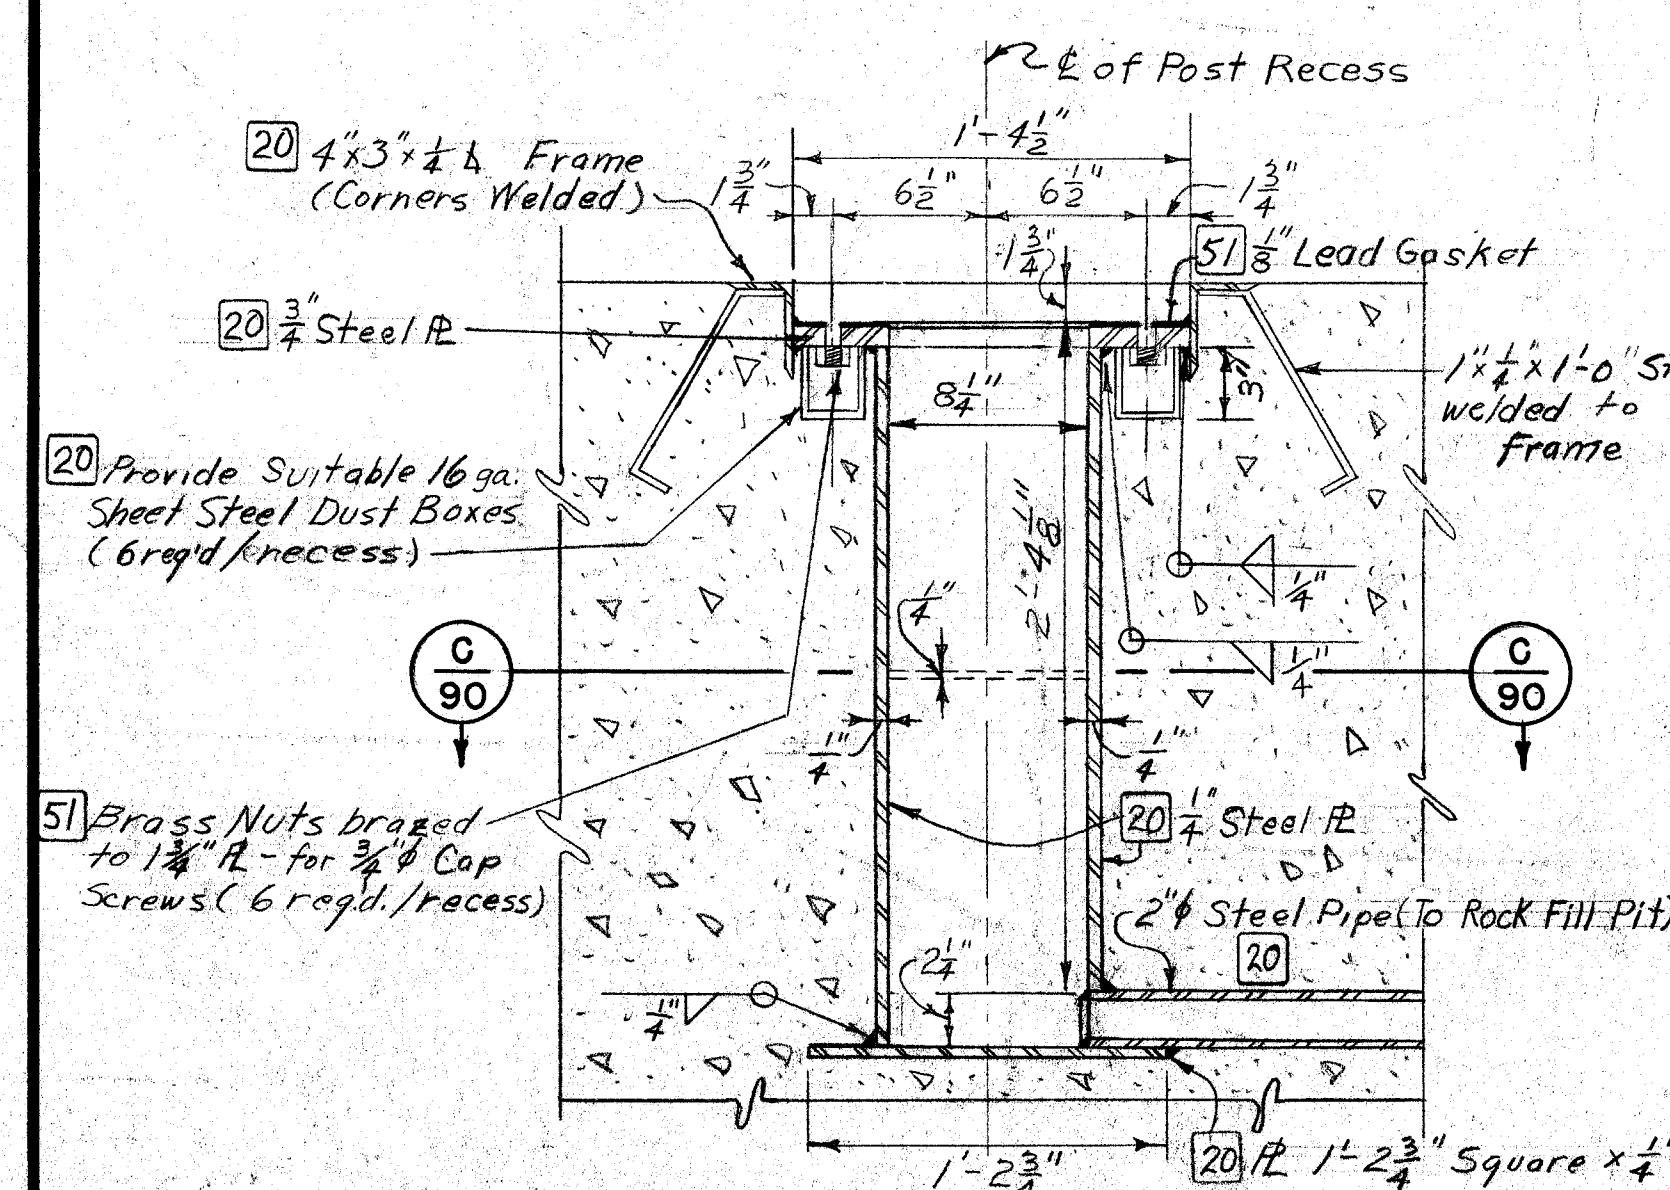


SECTION B 90

DETAILS OF POST RECESS

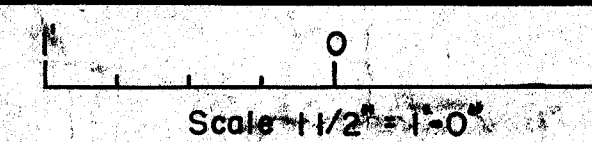


DETAIL OF POST BASE PLATE

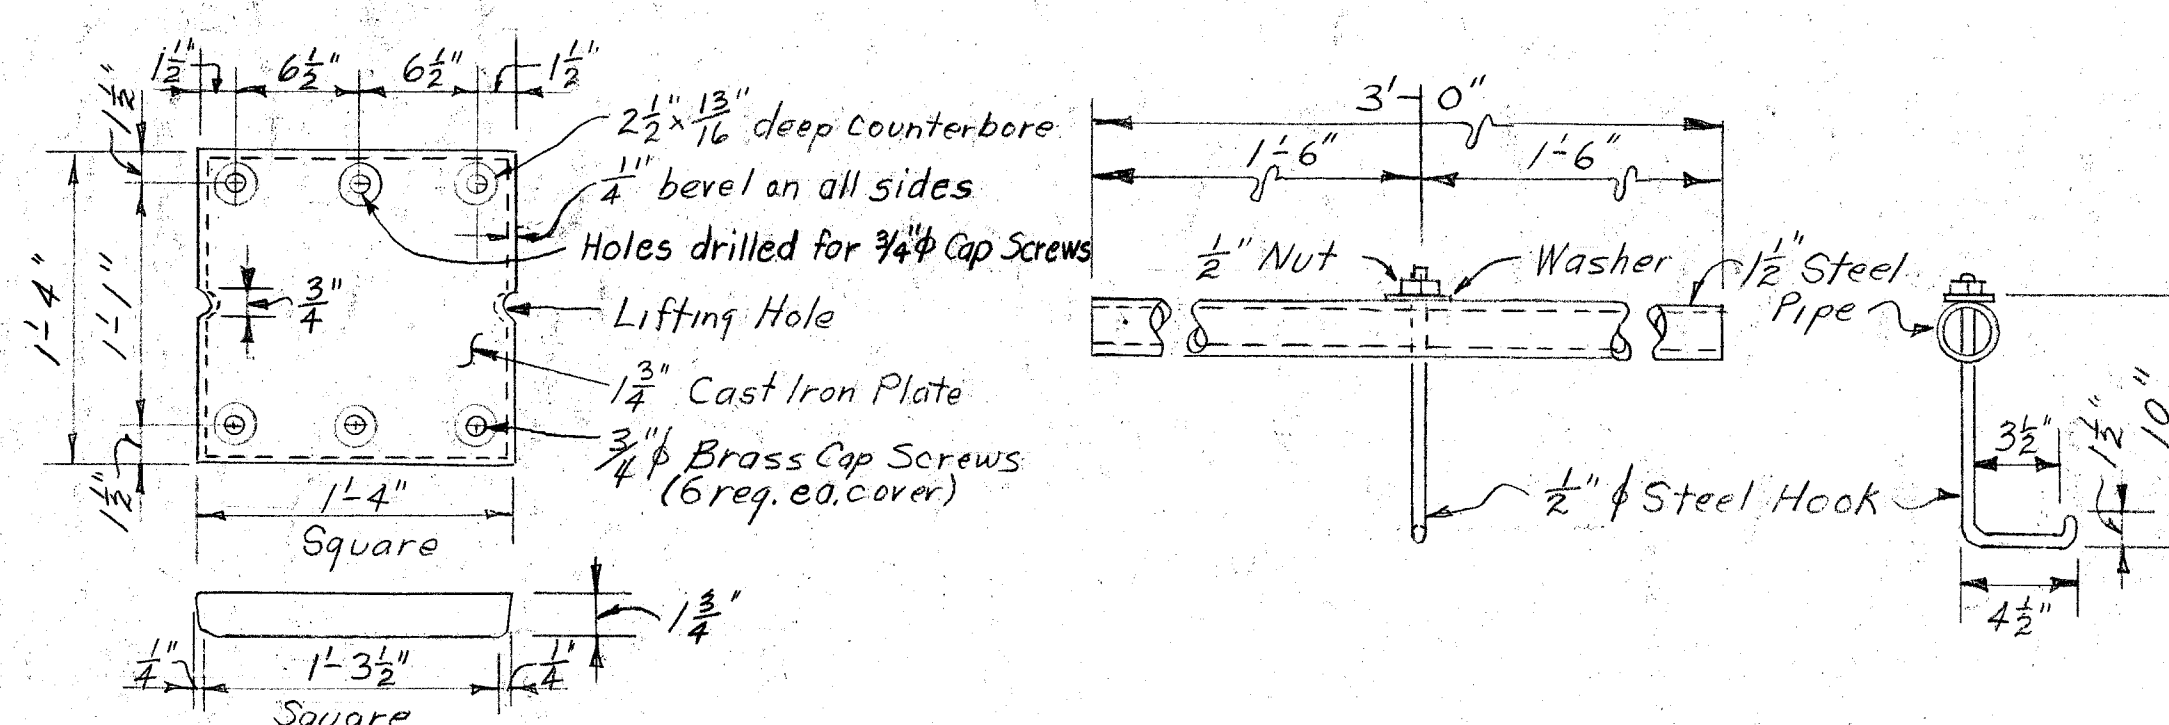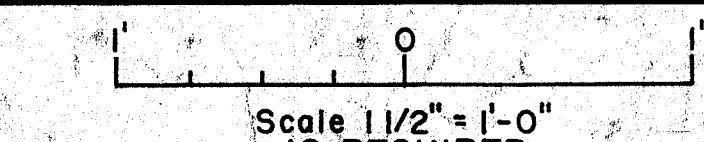
COVER PLATE
18 REQUIREDHANDLING HOOK
6 REQUIRED

DIMENSIONS OF STOP LOGS									
STRUCTURE	TYPE LOG	No. REQD	LENGTH	ALUMINUM CHANNEL	DIMENSION LINE				
Closure Str. No.1	A	10	8'-10 1/2"	6 C 2.83	V	W	X	Y	Z
Closure Str. No.1	A	10	6'-4 3/8"	6 C 2.83	1'-4"	4'-5 1/2"	2'-2 5/8"	5'-4"	2'-0"
Closure Str. No.2	A	62	7'-10 3/8"	6 C 2.83	1'-4"	3'-2 1/8"	1'-7 1/8"	4"	1'-10 3/8"
Closure Str. No.2	B	1	7'-10 3/8"	6 C 2.83	1'-6"	3'-11 1/8"	1'-11 1/8"	4"	1'-7 3/8"
Closure Str. No.2	C	1	7'-10 3/8"	6 C 2.83	1'-6"	3'-11 1/8"	1'-11 1/8"	4"	1'-7 3/8"
Drainage Str. No.6 (Outside)	A	5	7'-7 1/2"	6 C 2.83	1'-6"	3'-9 3/4"	1'-10 3/8"		

* Except as indicated for stepped side in detail at right.

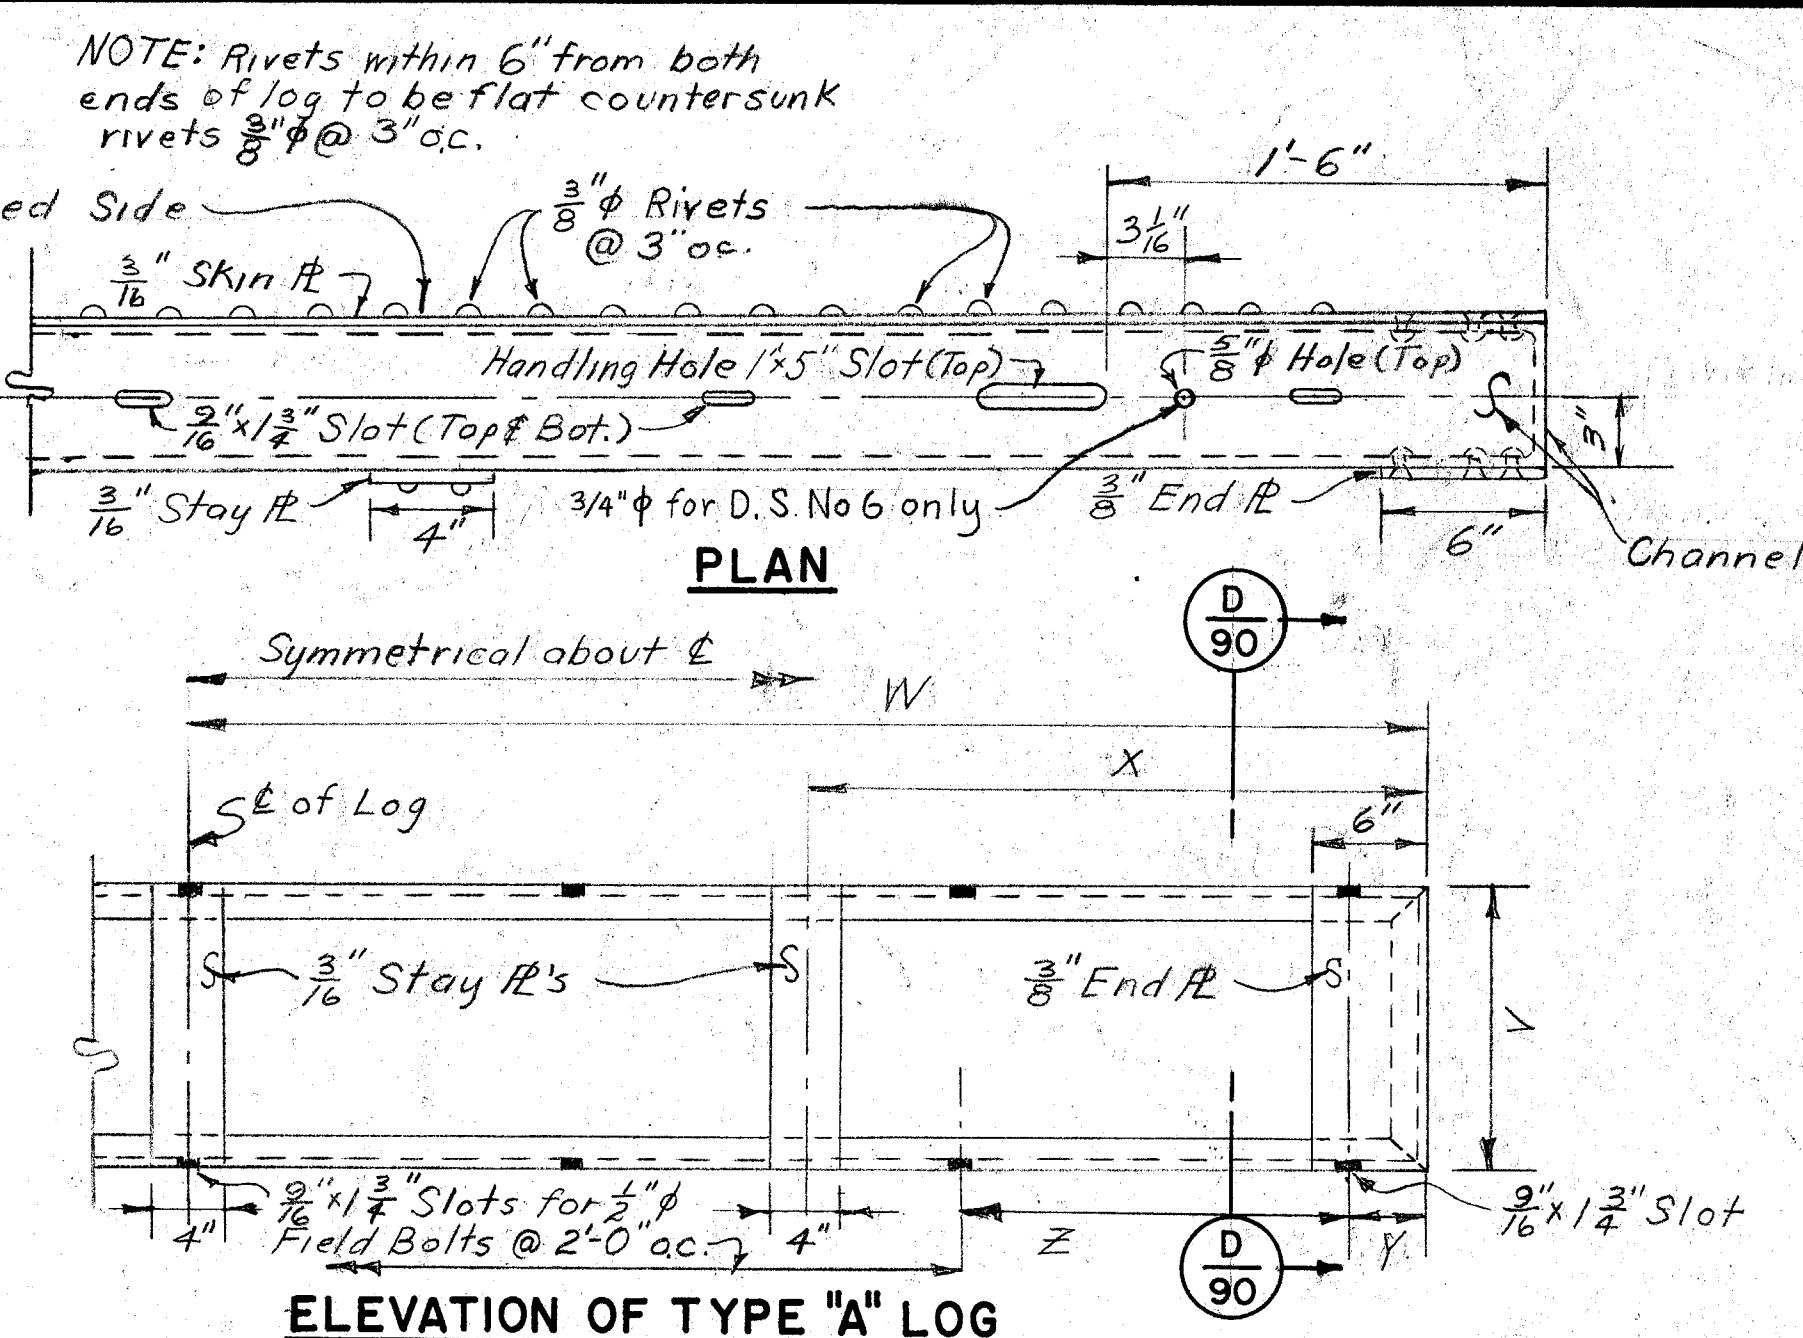

ELEVATION OF TYPE "A" LOG

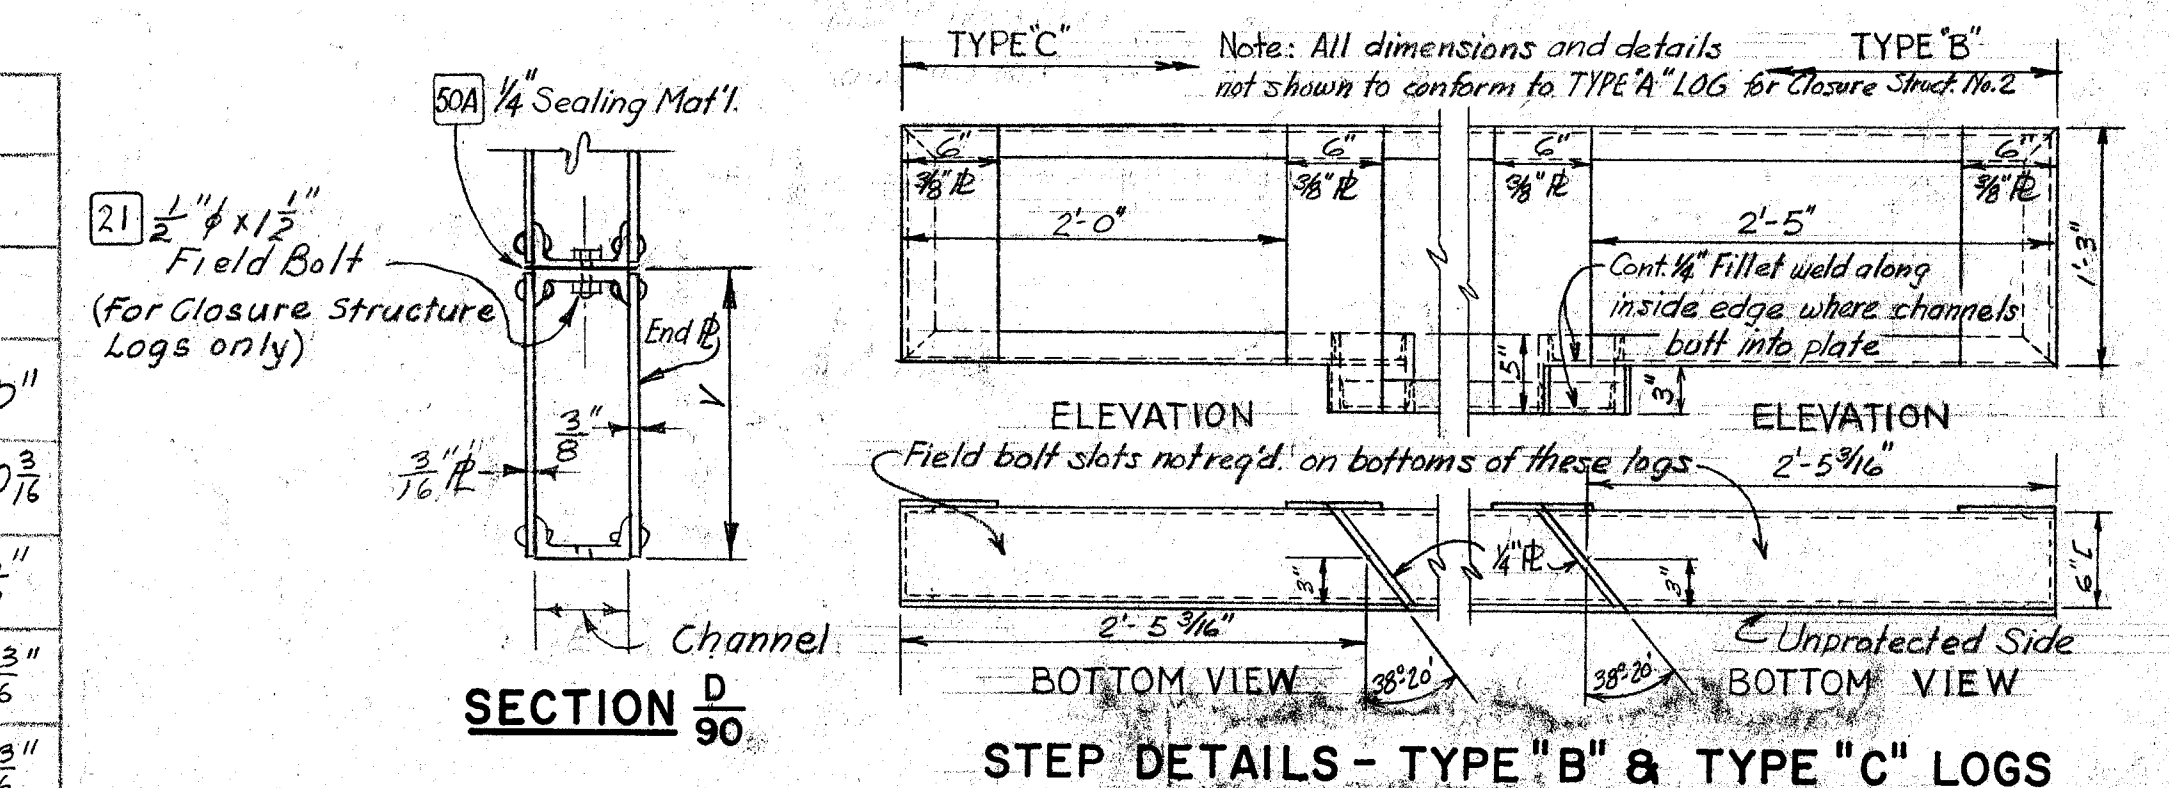


SECTION D 90

STEP DETAILS - TYPE "B" & TYPE "C" LOGS

DETAILS OF ALUMINUM STOP LOGS

Not to Scale

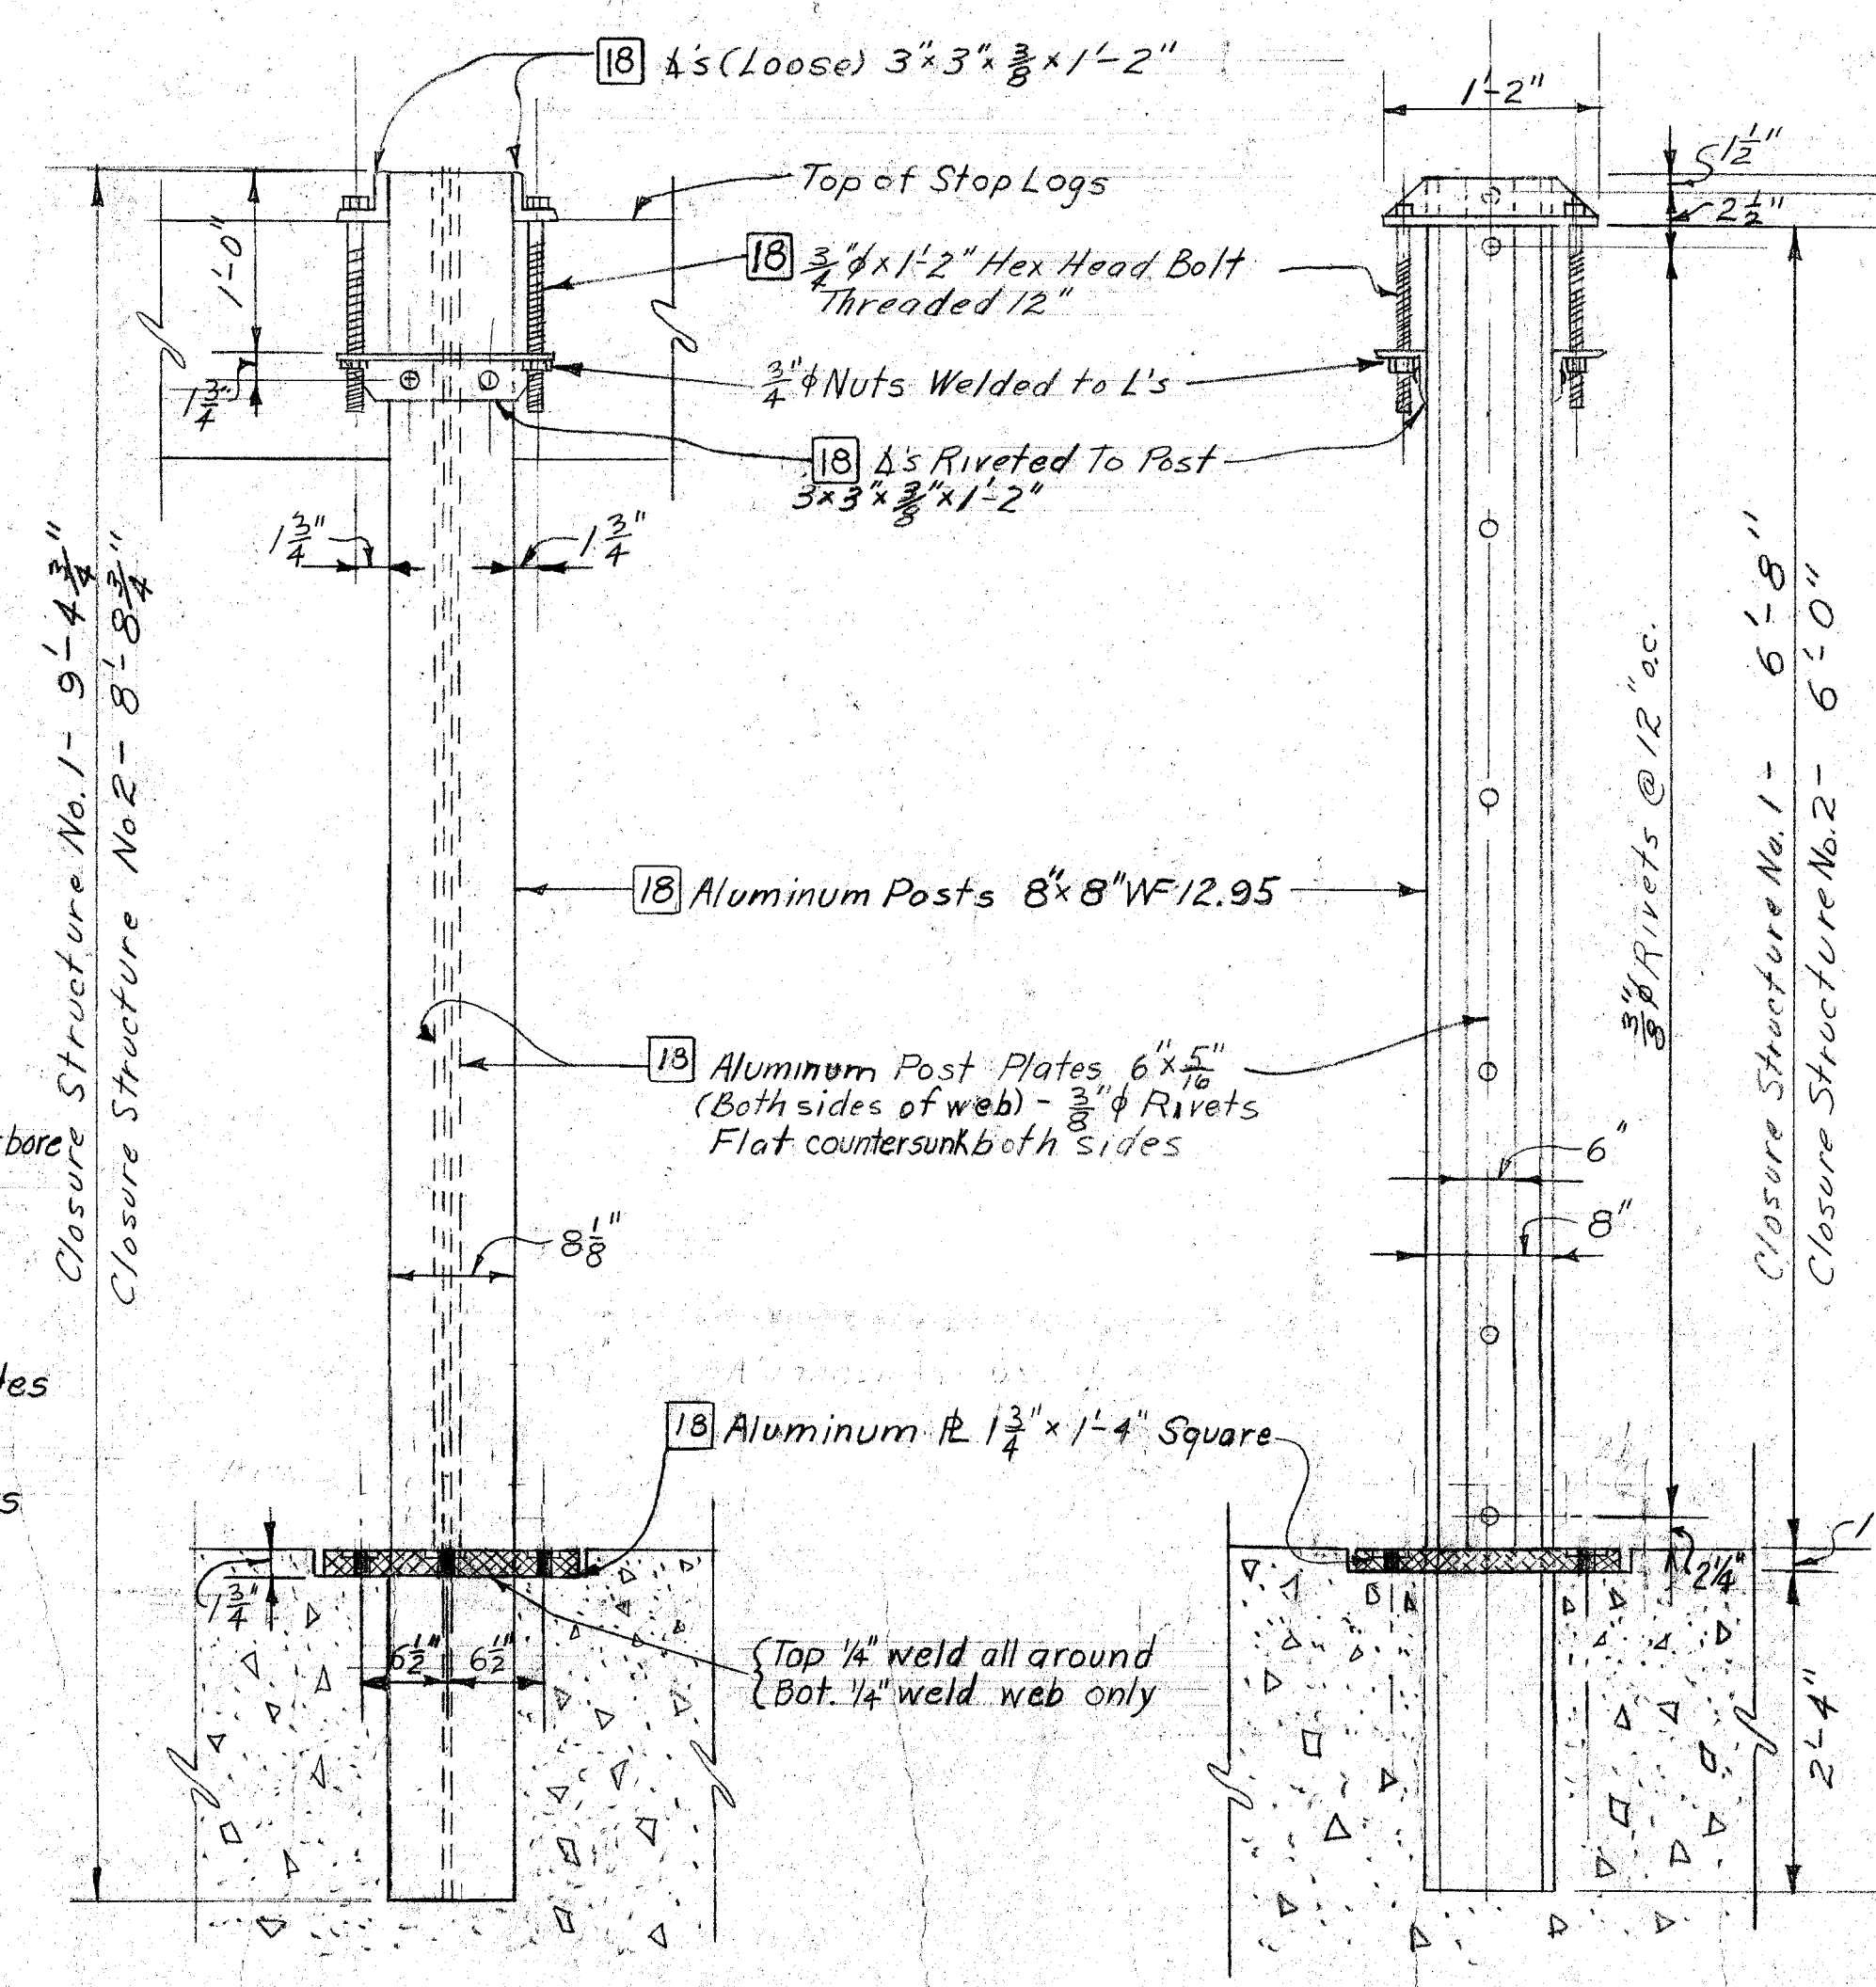


FRONT VIEW

SIDE VIEW

DETAILS OF CLOSURE STRUCTURE POSTS

Not to Scale
3 REQUIRED NO.1
15 REQUIRED NO.2

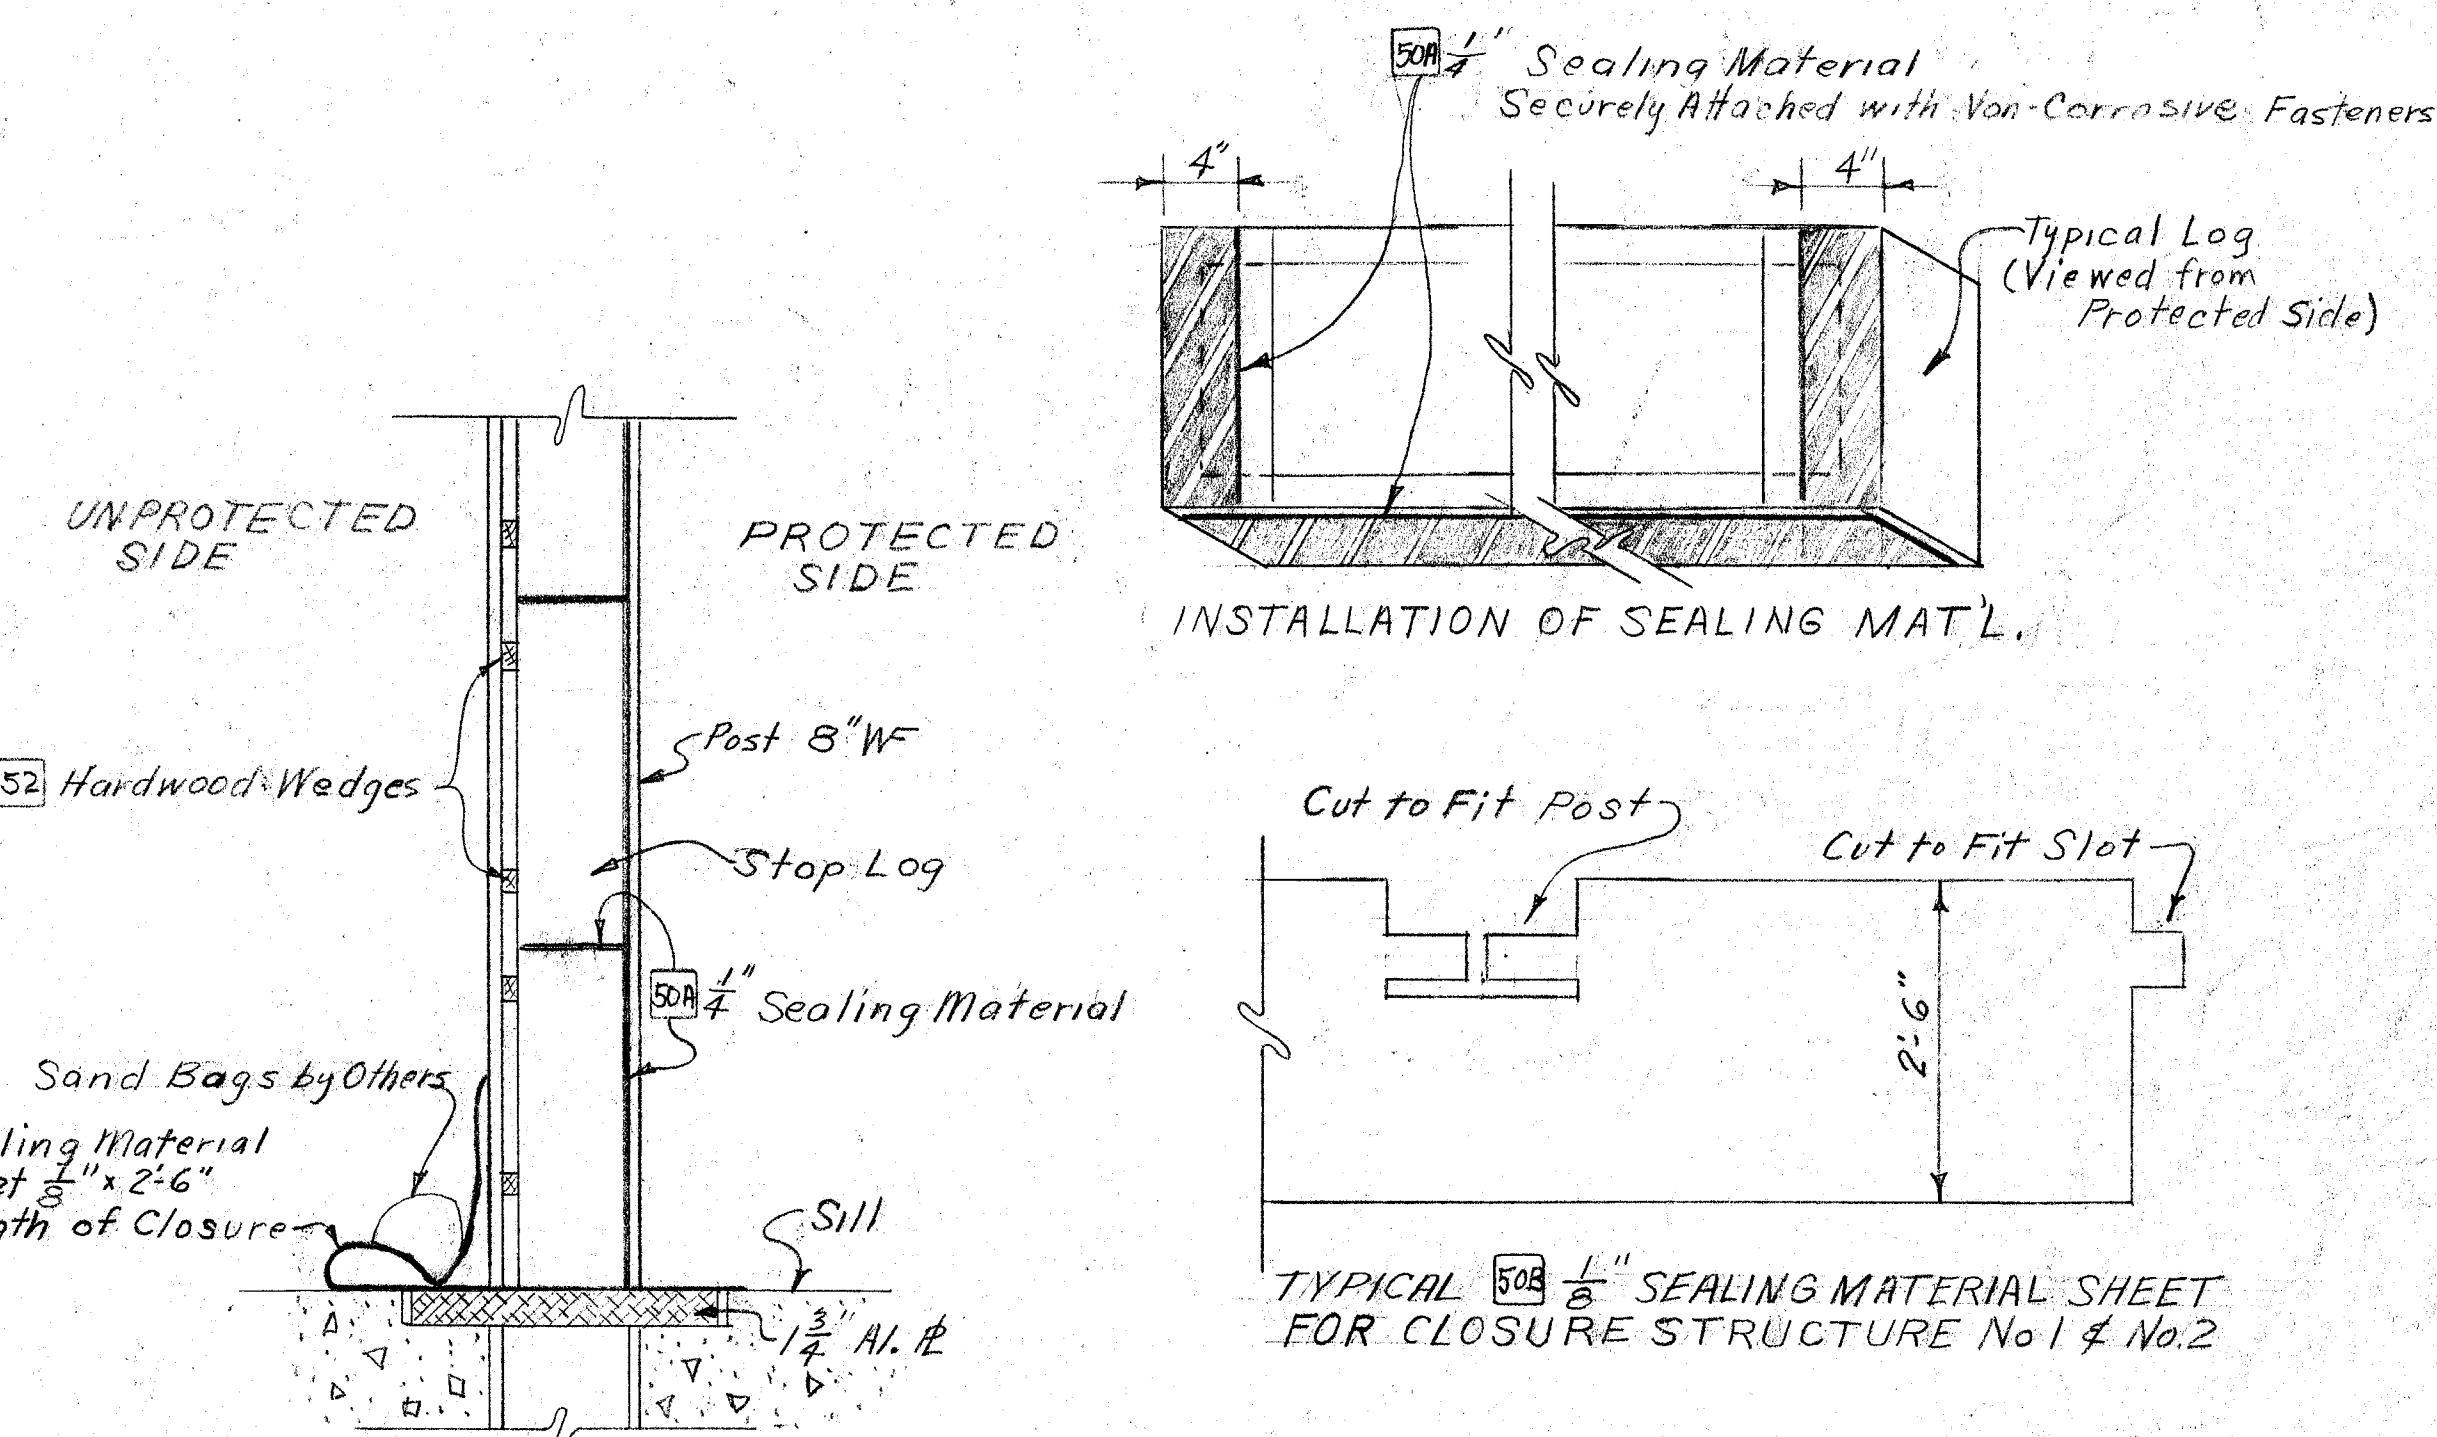

DETAILS OF LOG SEALING MATERIAL

Not to Scale

NOTES:
For General Notes see Sheet No.1.
For Location of Closure Structures No.1 & No.2, see Sheets No.11 & No.17.
For Details of Closure Structures No.1 & No.2, see Sheets No.87 & No.88.
For Location of Drainage Structure No.6 see Sheet No.27.
Structural Aluminum shall be high strength Aluminum Alloy known commercially as 2014-T6 (formerly 14S-T6) Min. yield strength 53 K/in², Min. Tensile strength 60 K/in².
For Concrete Notes, see Sheet No.56.
[8] Indicates Payment Item Number.

RECORD DRAWING

OF WORK - AS - BUILT

Colonel G. E. District Engineer
REVIEWED BY SAFETY BRANCH

OCT 14 1964 RECORD WORK AS BUILT (NO CHANGE)		BY
REVISION	DATE	DESCRIPTION
U. S. ARMY ENGINEERING DISTRICT, NEW YORK CORPS OF ENGINEERS NEW YORK 3, NEW YORK		
DRAWN BY: J. T.		MOHAWK RIVER BASIN HERKIMER FLOOD CONTROL PROJECT
CHECKED BY: ADP		CLOSURE STRUCTURES NO.1 & 2 - DETAILS
DESIGNED BY: [Signature]		NEW YORK
SUBMITTED: [Signature]		RECOMMENDED: [Signature]
REVIEWED: [Signature]		SCALE AS SHOWN
APPROVED: [Signature]		DRAWING NUMBER CC-HE-190 SHEET 90 OF 98
DATE: 12 OCT. 1961		