

# IDENTIFICATION

MILEPOST 240.48

BIN 5512980

DESCRIPTION JUDD ROAD OVER  
90IX


☐ "AS-BUILTS"

☒ CONTRACT

CONTRACT NO. M.T. 52-12



SHEET NOS. 37-46

NEW YORK STATE

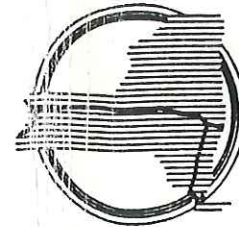

THRUWAY AUTHORITY

## GENERAL INSPECTION PLAN REVIEW LOG

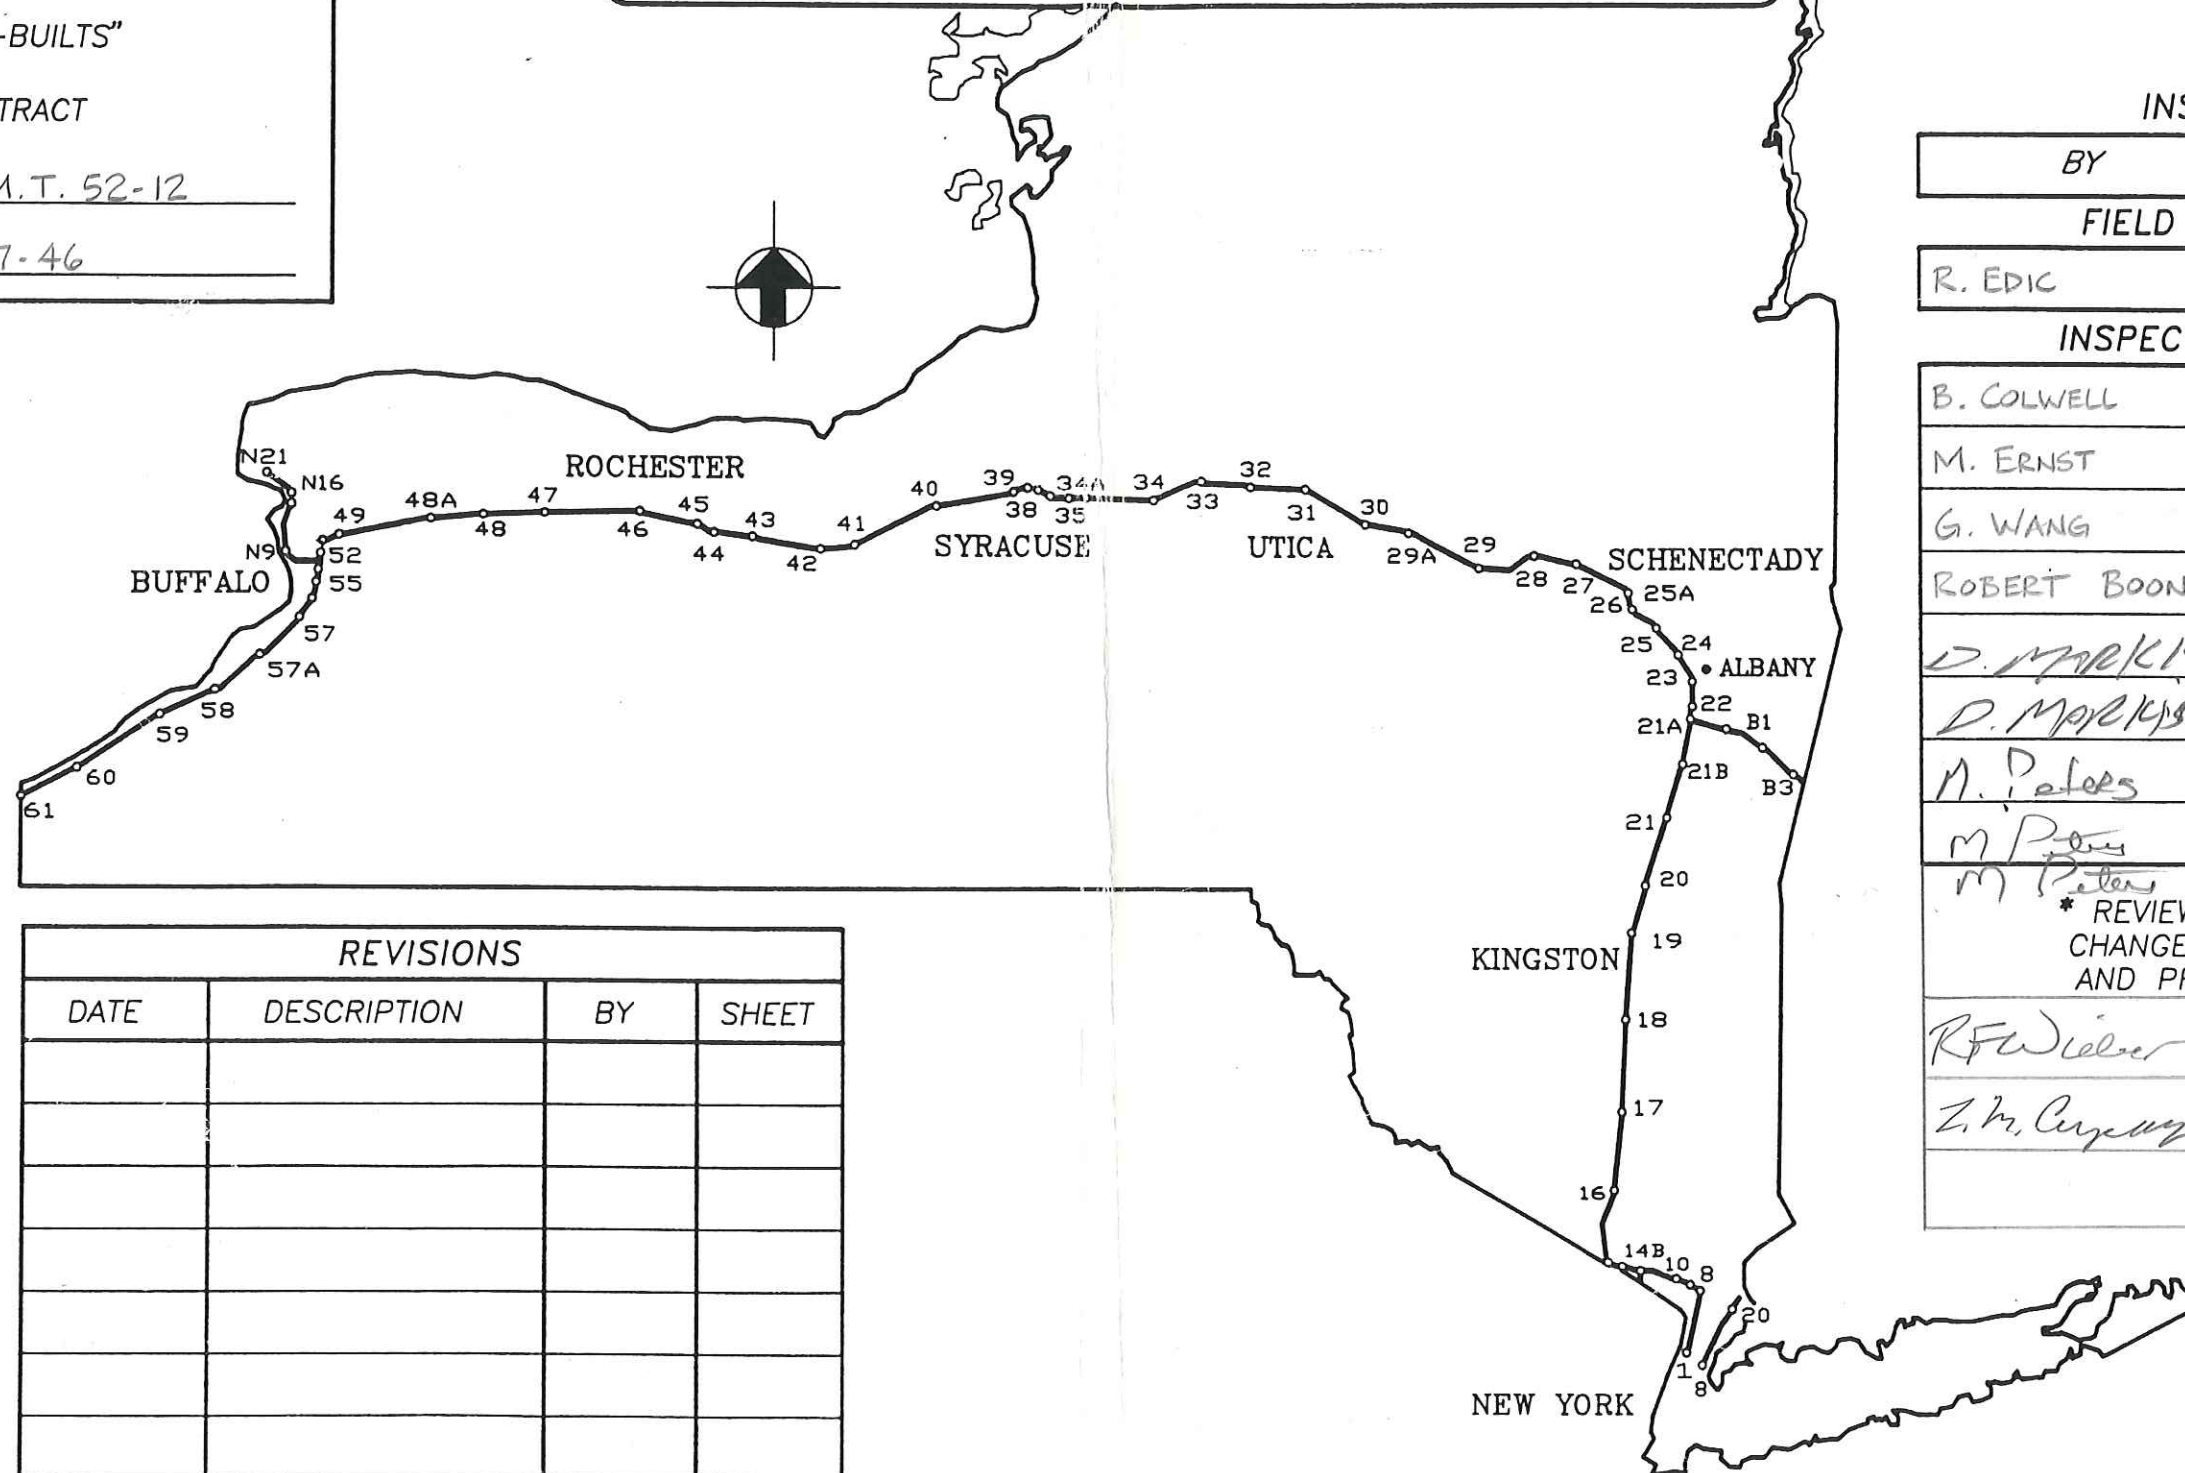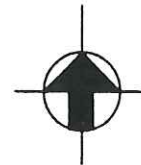

### REVISIONS

DATE	DESCRIPTION	BY	SHEET

### INSPECTIONS

BY	PE NO.	DATE
----	--------	------

### FIELD VERIFICATION

R. EDIC		11/29/84
---------	--	----------

### INSPECTION REVIEW \*






B. COLWELL	46031	10/23/86
M. ERNST	63707	11/2/88
G. WANG	7221(NH)	10/15/90
ROBERT BOONE	60047	11/12/92
D. MARKIS	53518	10/31/97
D. MARKIS	59170	9/16/96
M. Peters	68102	9/24/98
M. Peters	68102	8/24/00
M. Peters	68102	8/12/02
* REVIEWED FOR MAJOR CHANGES IN DEAD LOADS AND PRIMARY MEMBERS.		
RFWilber	067313	9/18/04
Z. M. Cuyana	044297	6/1/06



240.48  
5512980



M.T. 52-12	S.T. 52-26
COUNTY	SHEET NO. TOTAL SHEETS
ONEIDA	37 • 74
N.Y. STATE THRUWAY - MOHAWK SECT. SUB-DIV. 7	
WESTMORELAND TO WHITESBORO	

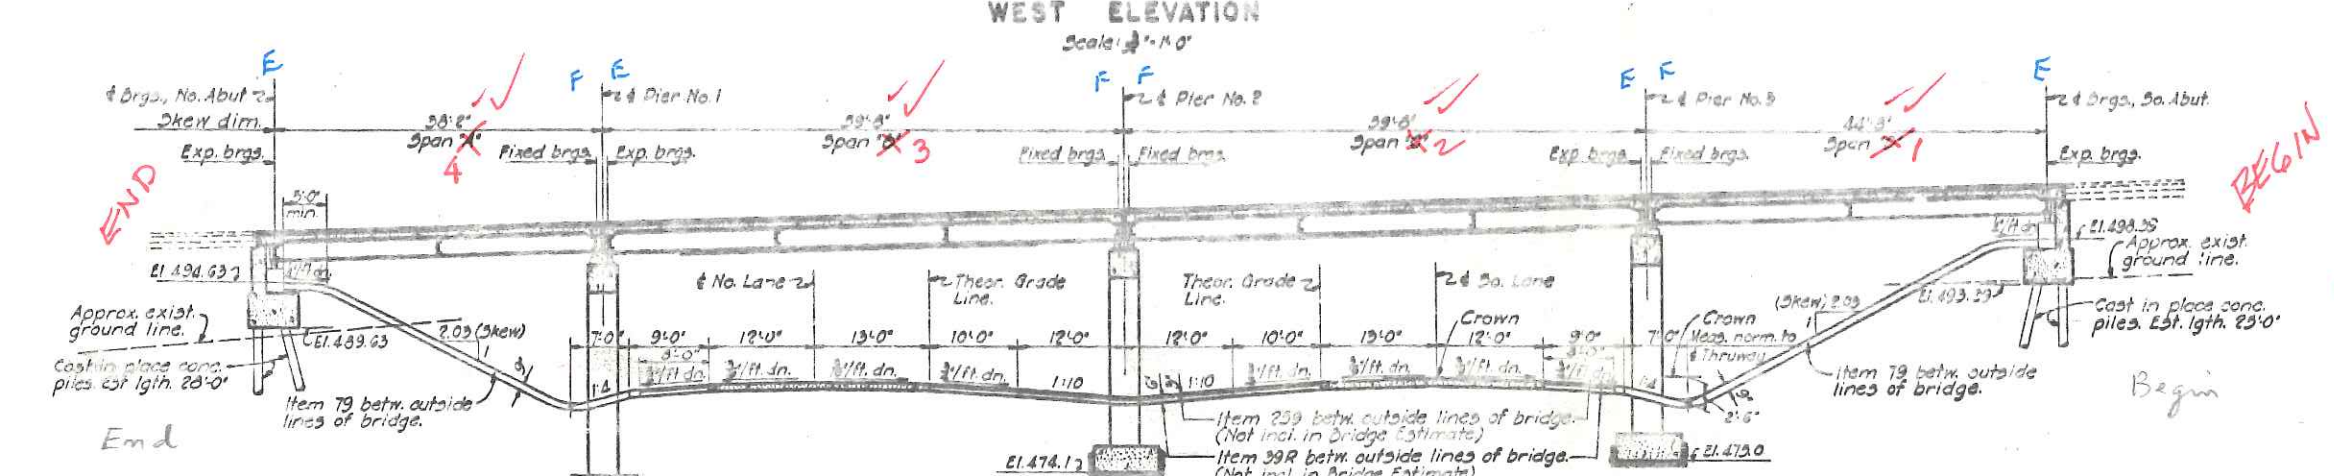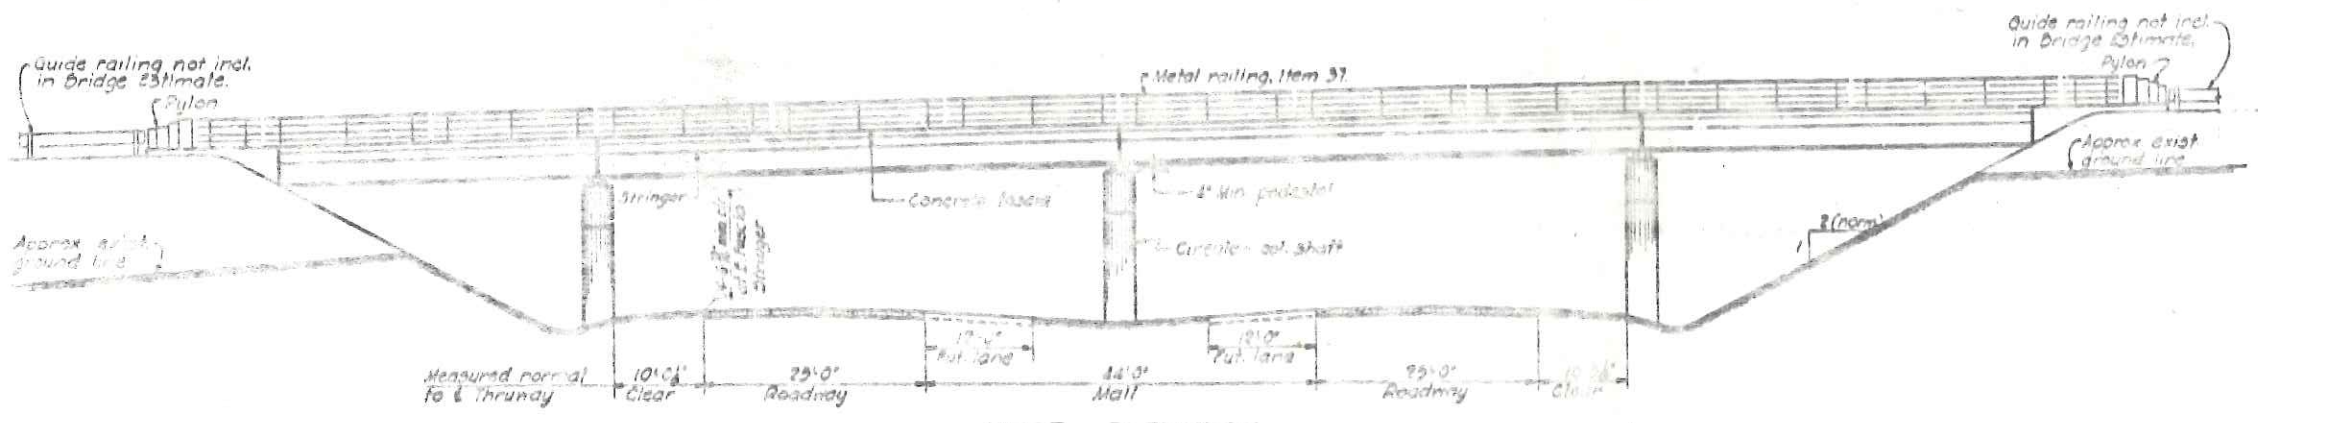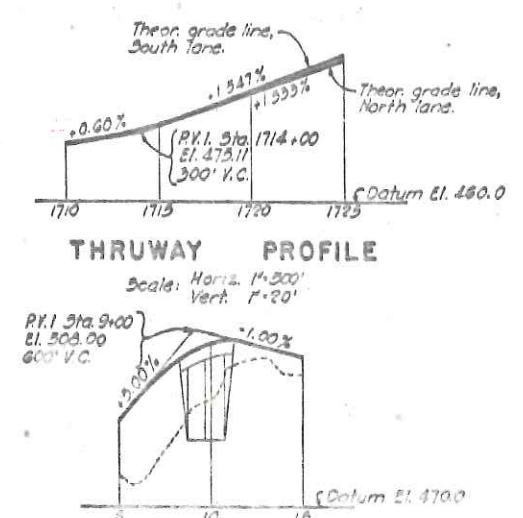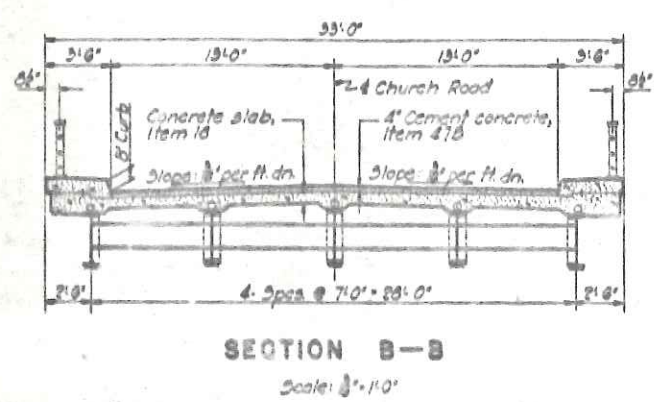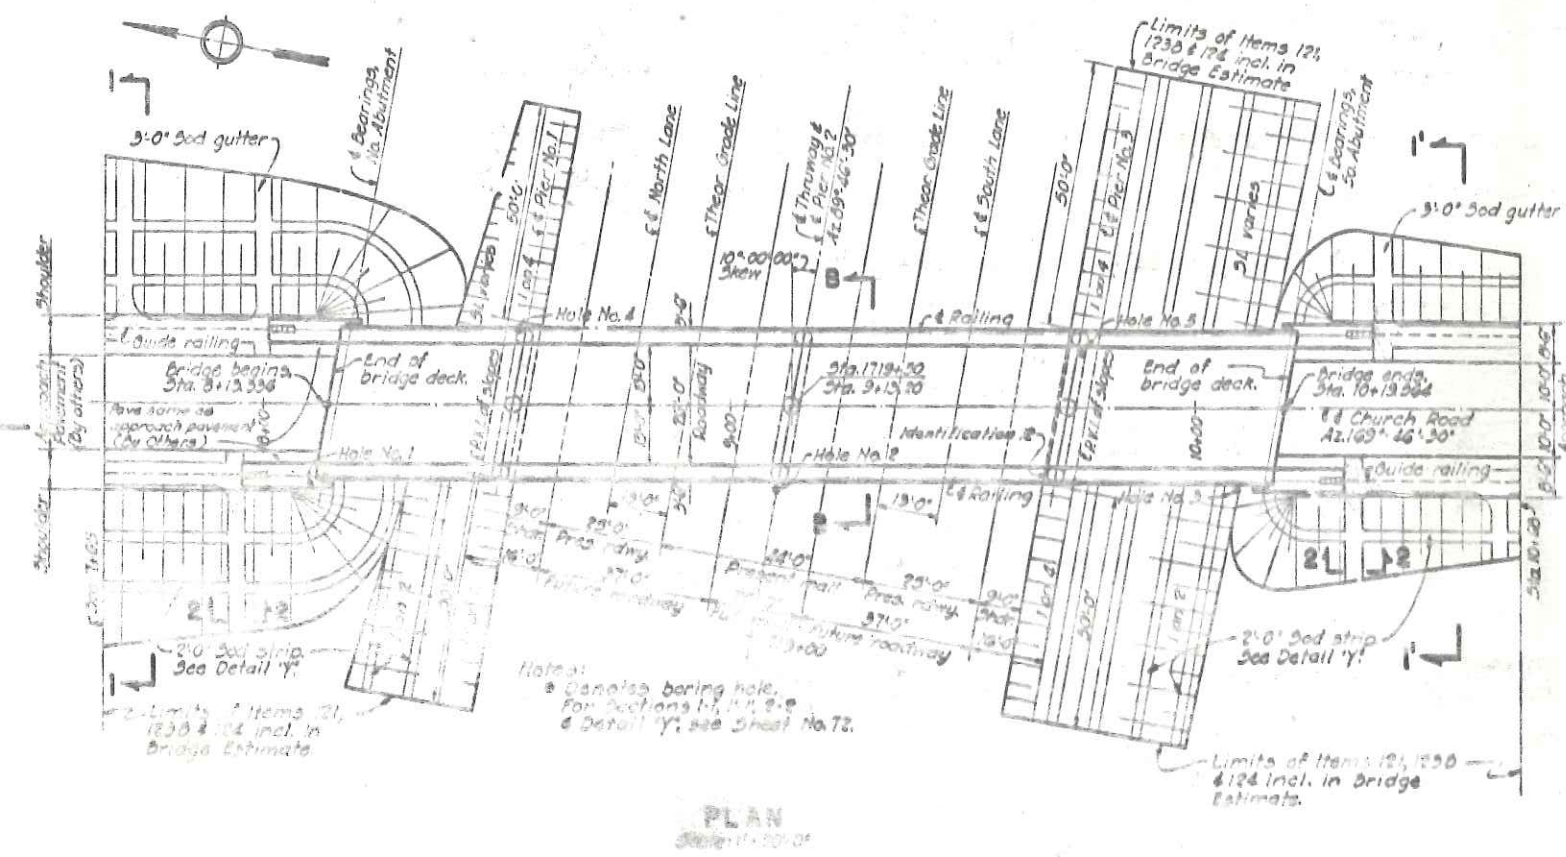

DEPARTMENT OF PUBLIC WORKS

RECOMMENDED *Wm. H. Johnson* July 31, 1952.  
DISTRICT ENGINEER DATE

APPROVED *E. J. Johnson* 8/8/52  
DEPUTY CHIEF ENGINEER DATE

*W. H. Johnson* 8/8/52  
DEPUTY CHIEF ENGINEER DATE

*J. H. Johnson* 8/8/52  
CHIEF ENGINEER DATE

APPROVED *August 8* 1952  
NEW YORK STATE THRUWAY AUTHORITY

BERTRAM D. TALLAMY Chairman

By: C. H. LANG


*C. H. Lang*  
DEPUTY CHIEF ENGINEER

*Robert Beane* PE 60047  
11-12-92


DEPARTMENT OF COMMERCE  
BUREAU OF PUBLIC ROADS  
RECOMMENDED FOR APPROVAL

DISTRICT ENGINEER DATE



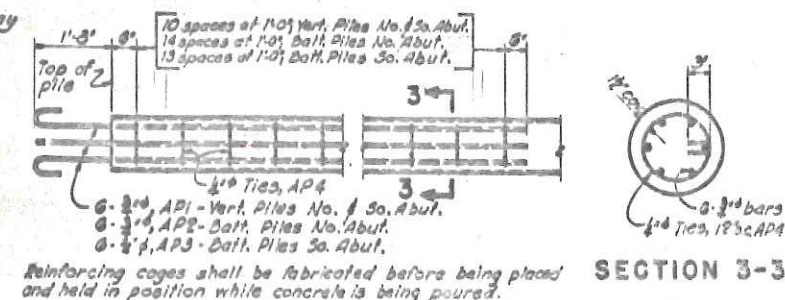

SECTION 1-1  
SECTION 1'-1" SIMILAR  
SECTION THRU ROADWAY EMBANKMENT  
Scale: 1" = 10'


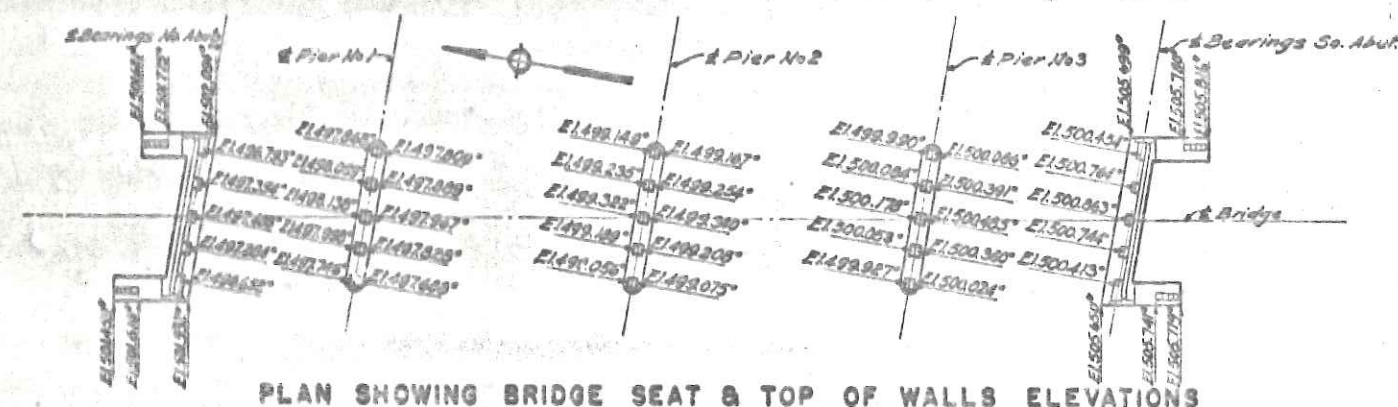


PLAN SHOWING BRIDGE SEAT & TOP OF WALLS ELEVATIONS


### GENERAL NOTES

All concrete except in pavement & pylons shall be Item 10.  
Concrete in pavement shall be Item 47 'Cement Concrete Pavement'.  
Concrete in pylons shall be Item 19 'Class A Concrete for Railings'.  
The cost of furnishing & installing caulking compound, premodulated bituminous joint material, sponge rubber joint material, lead wool, copper flashing & baffle strips, Common Brick in Asphalt Mastic, shall be included in the Price bid for the various items in this Contract.  
After the concrete is cured the Contractor shall apply a waterproofing oil treatment as described in the Specifications for M-414 to all exposed surfaces except the underside of slabs.  
Two applications of waterproofing oil treatment shall be applied to the top of the slab. The second application shall be applied two days prior to the placing of the pavement or sidewalk.  
Materials & Fabrication - Specifications of New York State Department of Public Works dated Jan. 8, 1931 and current modifications & additions.  
Design Specifications - A.A.S.H.O. 1949 Loading H-20 - 316-44 modified.  
The Contractor's attention is directed to the Special Notes for this structure which appear in the Proposal. Particular attention should be given to the Foundation Note, which briefly outlines the anticipated subsurface conditions at the site of the structures and which specifies certain requirements relative to construction. No construction joints other than those shown on the Plans will be permitted without the written permission of the Deputy Chief Engineer (Bridges).  
Where caulking compound is to be used the sides of the joints shall be formed with a material satisfactory to the Manufacturer of the caulking compound 20 to 30 minutes before the compound is placed. All joints must be thoroughly clean & dry before the priming coat is applied. Work must be performed by workmen experienced in this type of work.  
For design purposes, the assumed load per pile does not exceed 30 tons. The assumed pressure for the footings founded on soil does not exceed 3.75 tons per sq. ft.  
Where steel exceeding one inch in thickness is to be welded, electrodes of Classification Number E6015 or E6016 shall be used.  
Immediately before placing pavement concrete, the concrete surface or surfaces upon which it is to be placed shall be thoroughly wetted down continuously for one hour, if the air temperature is above 30° F.  
Sponge rubber shall meet the requirements of the Standard Specifications for preformed expansion joint fillers for concrete A.S.T.M. Designation D-544.




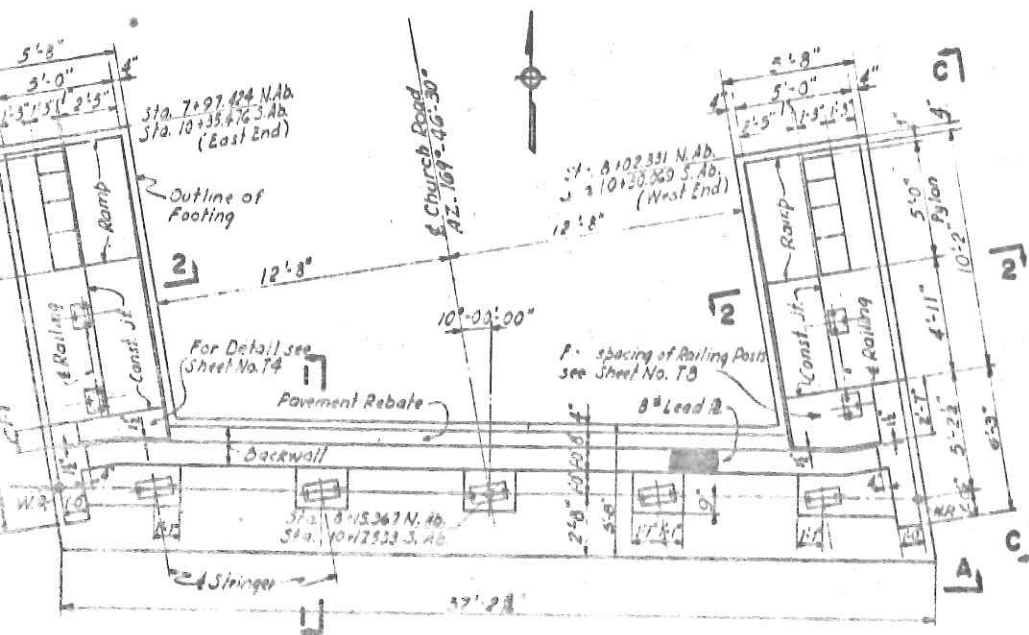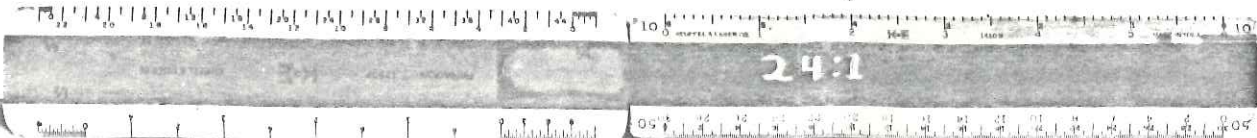


PLAN - NORTH ABUTMENT  
South Abutment Similar as Noted

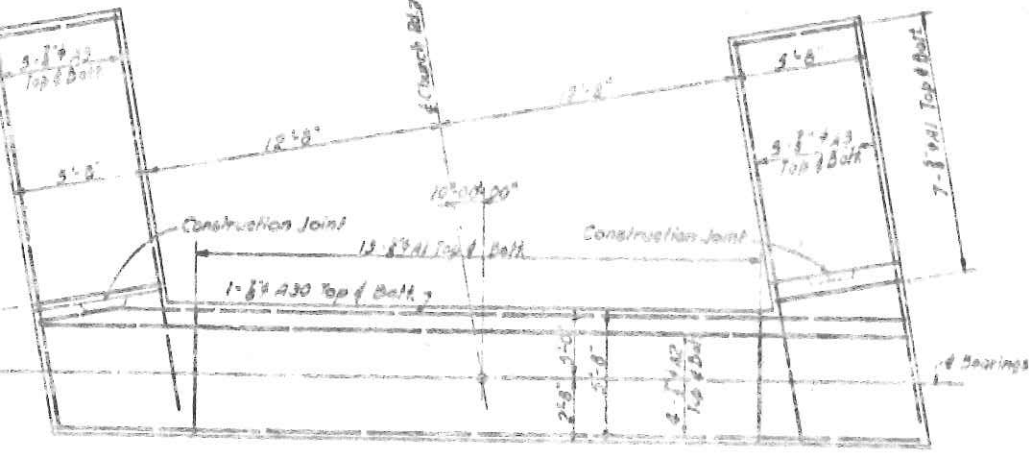


PLAN OF FOOTING REINFORCEMENT

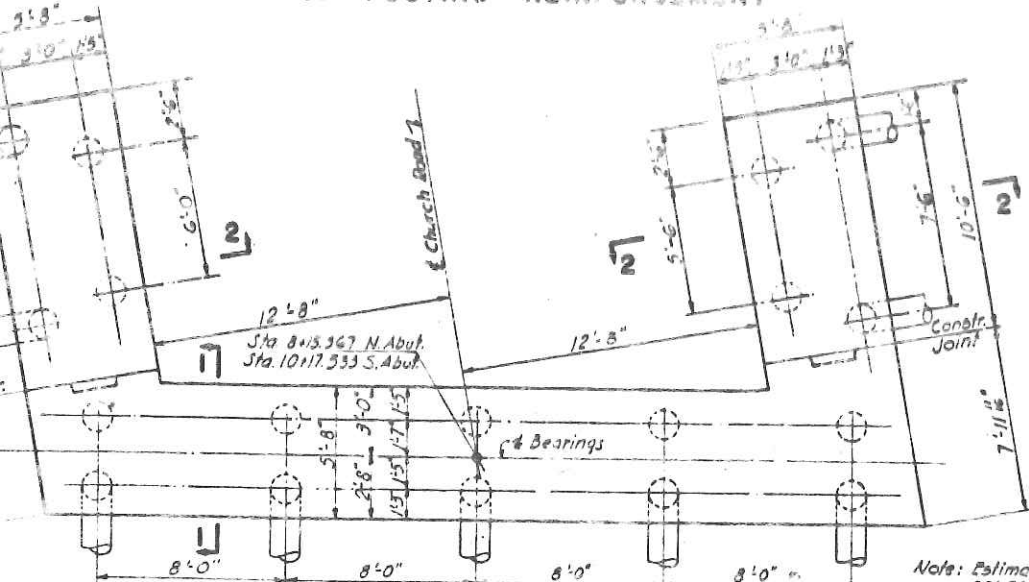

SECTIONAL PLAN D-D

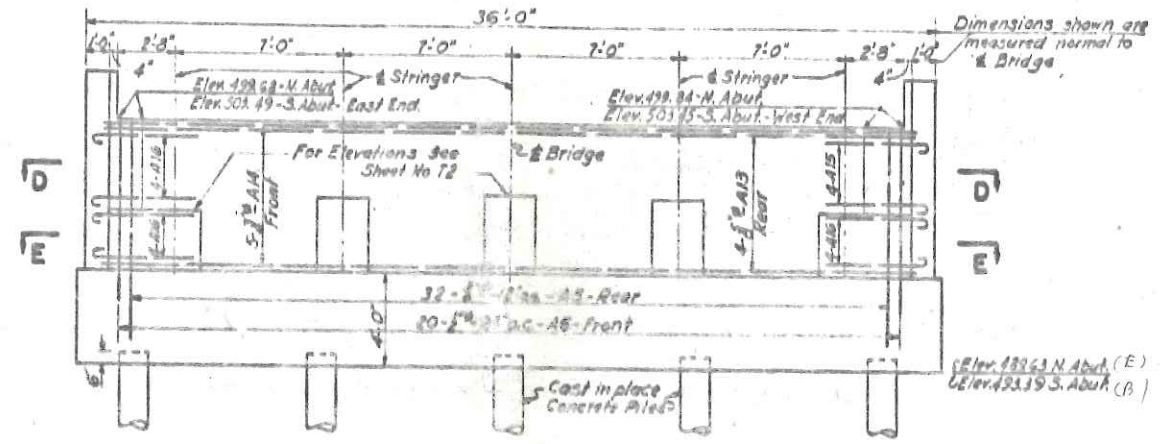


ELEVATION A-A - NORTH ABUTMENT

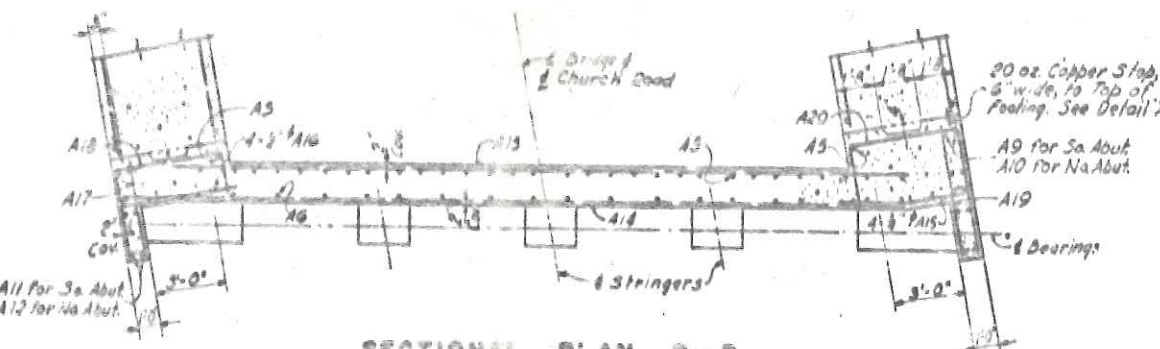


SECTIONAL PLAN E-E


M.T. 52-12		S.T. 52-26	
COUNTY	ONEIDA	SHEET NO.	TOTAL SHEETS
		39	74
N. Y. STATE THRUWAY - MOHAWK SECT. SUB-DIV. 7			
WESTMORELAND TO WHITESBORO			

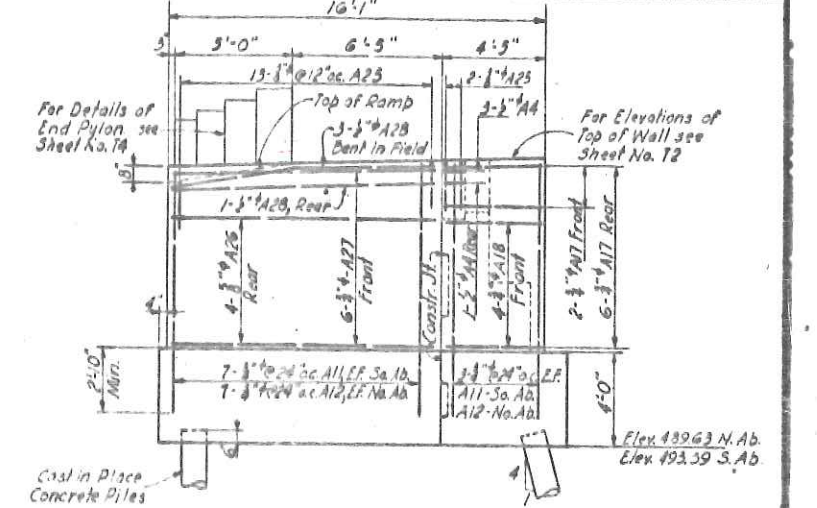

ELEVATION B-B  
WEST WING NORTH ABUTMENT  
East Wing South Abutment Similar except as noted

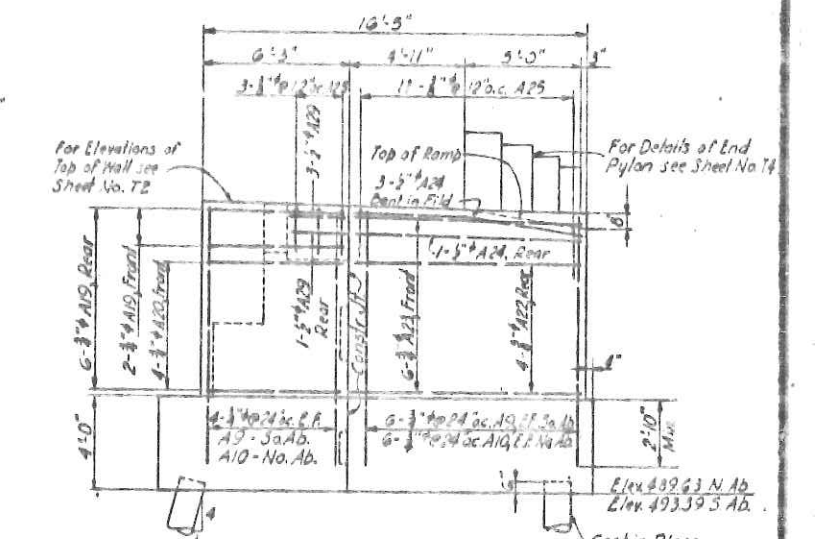








ELEVATION C-C  
EAST WING NORTH ABUTMENT  
West Wing South Abutment Similar except as noted

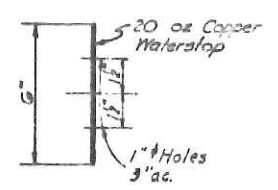


DETAIL "X"  
Scale: 3"=1'-0"

Note: Estimated Length of Piles



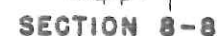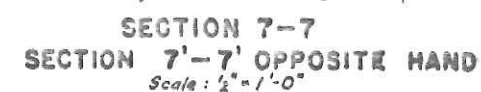
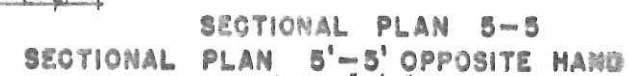
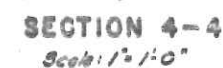
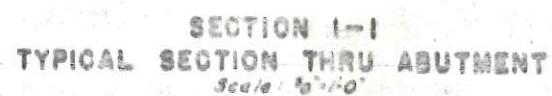
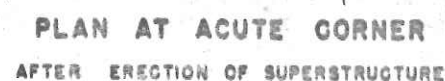
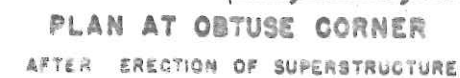




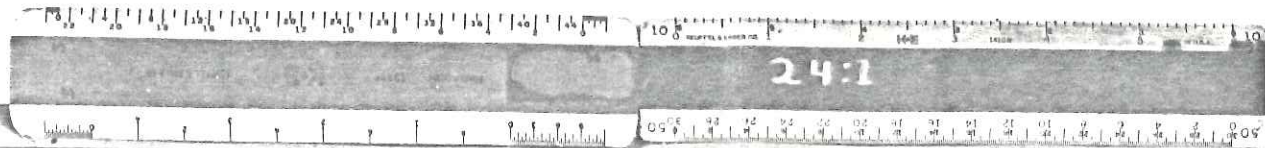



M.T. 52-12 S.T. 52-26

COUNTY	SHEET NO.	TOTAL SHEETS
ONEIDA	41	74
N.Y. STATE THRUWAY — MOHAWK SECT. SUB-DIV. 7		
WESTMORELAND TO WHITESBORO		

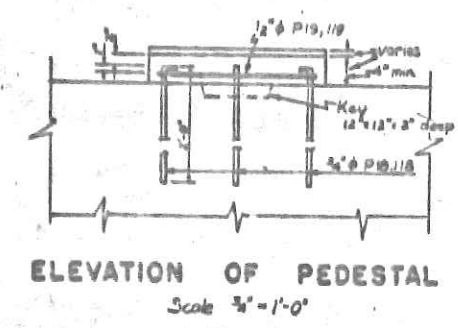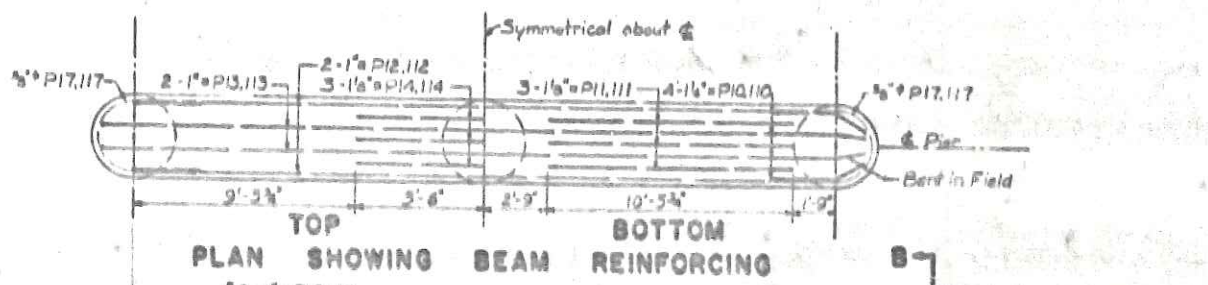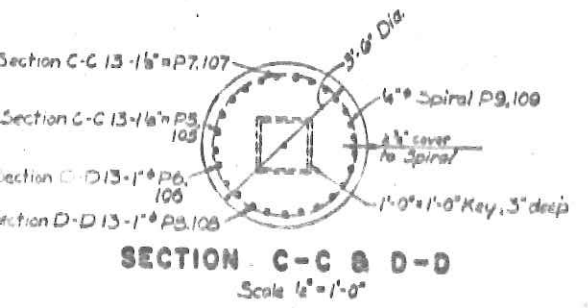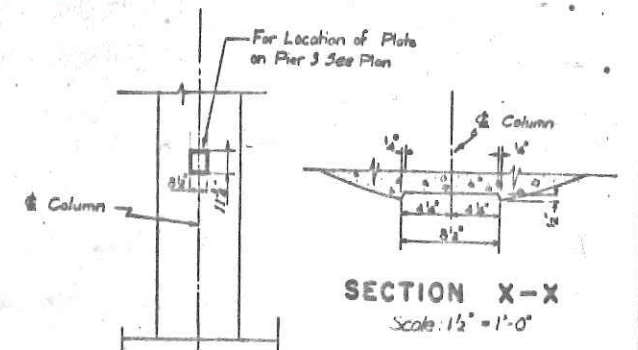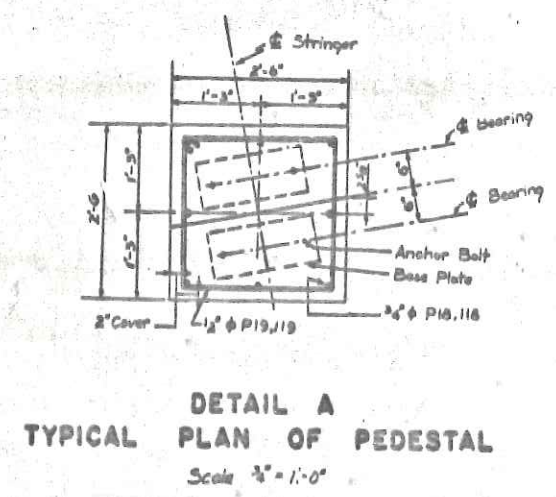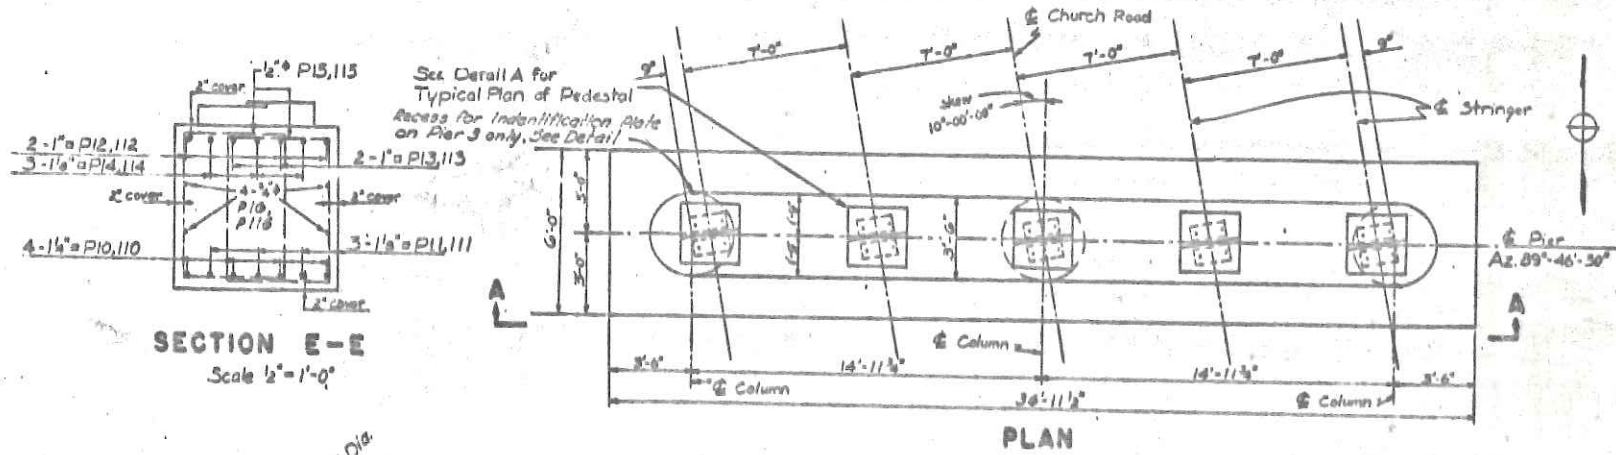


DETAIL OF IDENTIFICATION PLATE RECESS

Note: See Std. Sheet 52-41  
Scale: 1/2" = 1'-0"

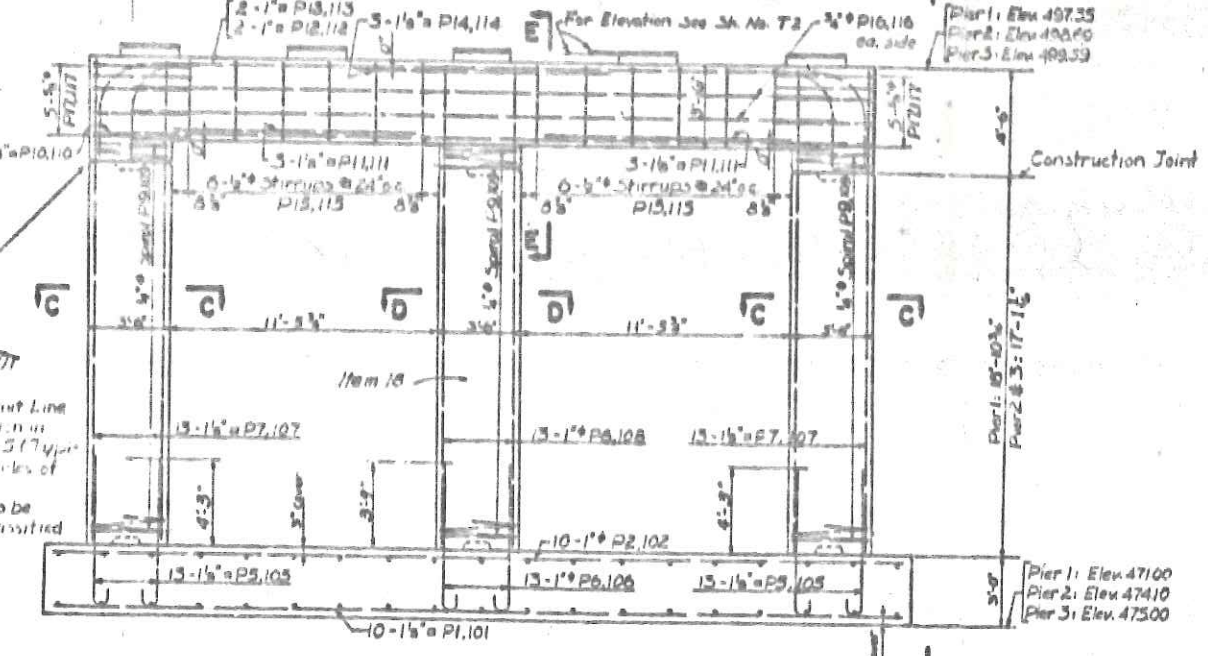
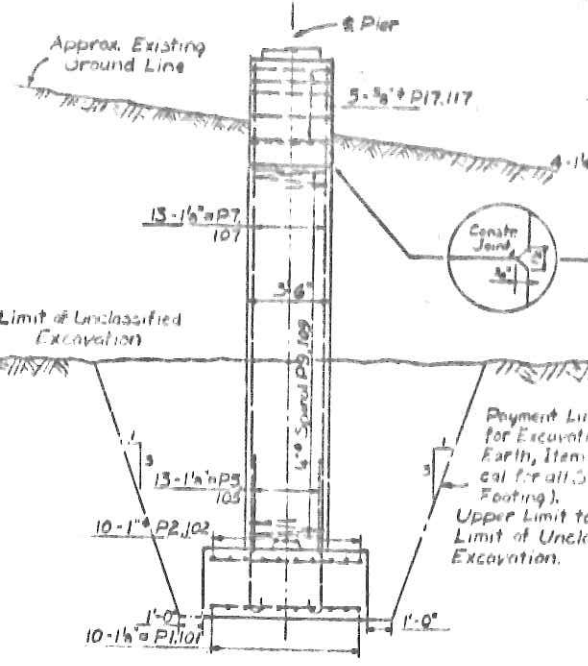


Notes: Anchor Bolts for Bearings shall be set at the same time that the steel in Pier Beam is placed.  
Steel in Top of the Beam may be moved slightly in order to clear Anchor Bolts if necessary.



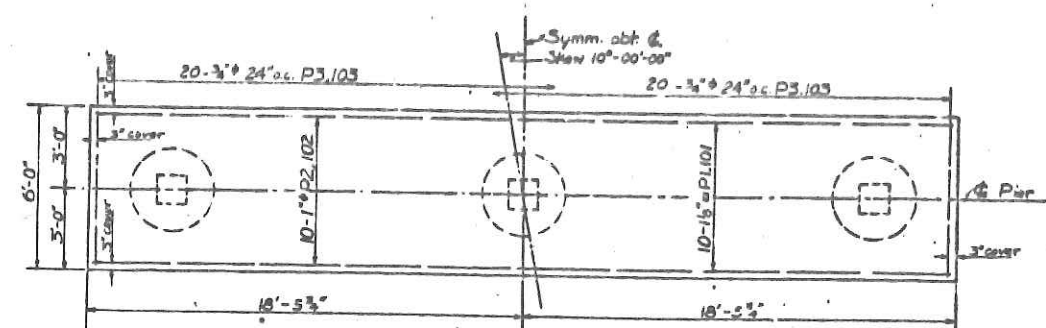




COUNTY	SHEET NO.	TOTAL SHEETS
ONEIDA	42	74
N.Y. STATE THRUWAY — MOHAWK SECT. SUB-DIV. 7		
WESTMORELAND TO WHITESBORO		

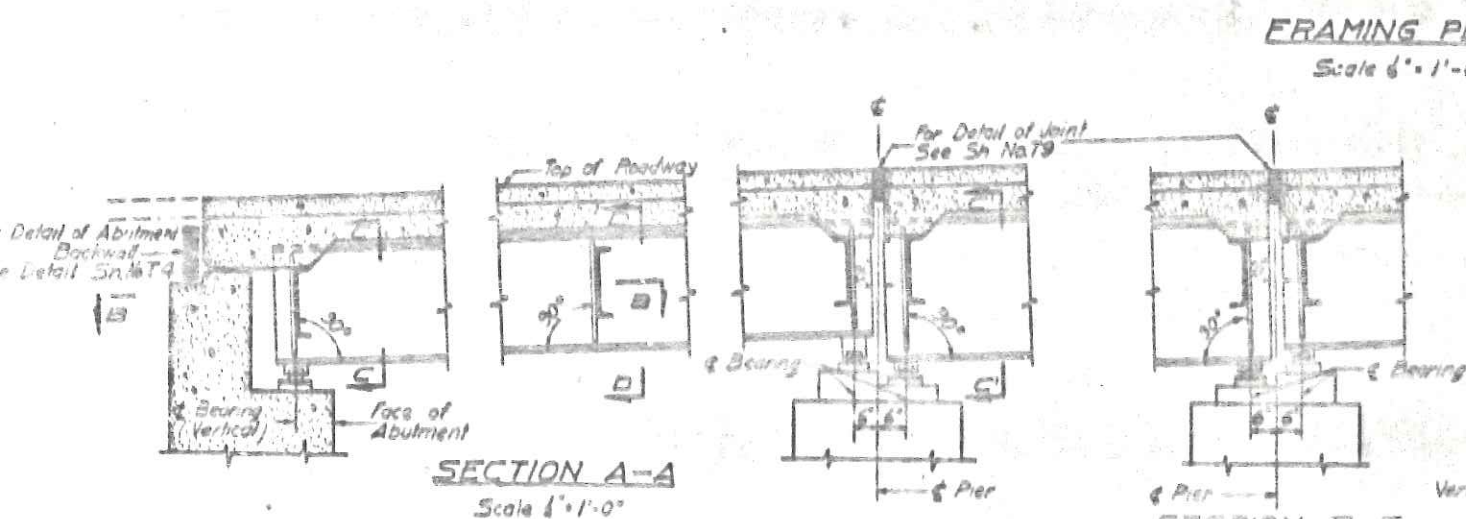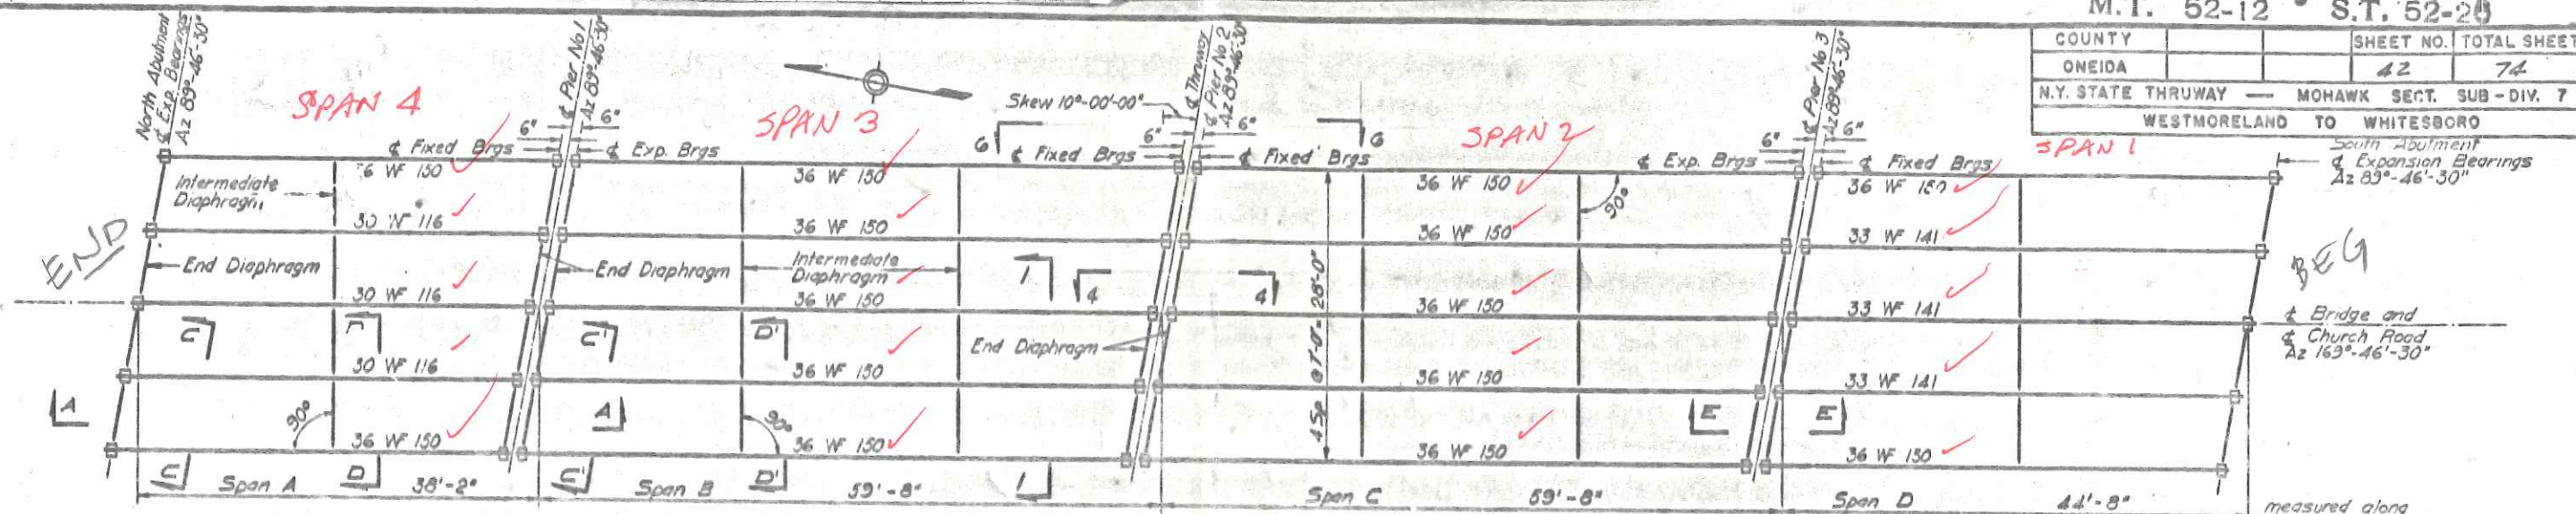


SECTION E-E Scale 1/2" = 1'-0"

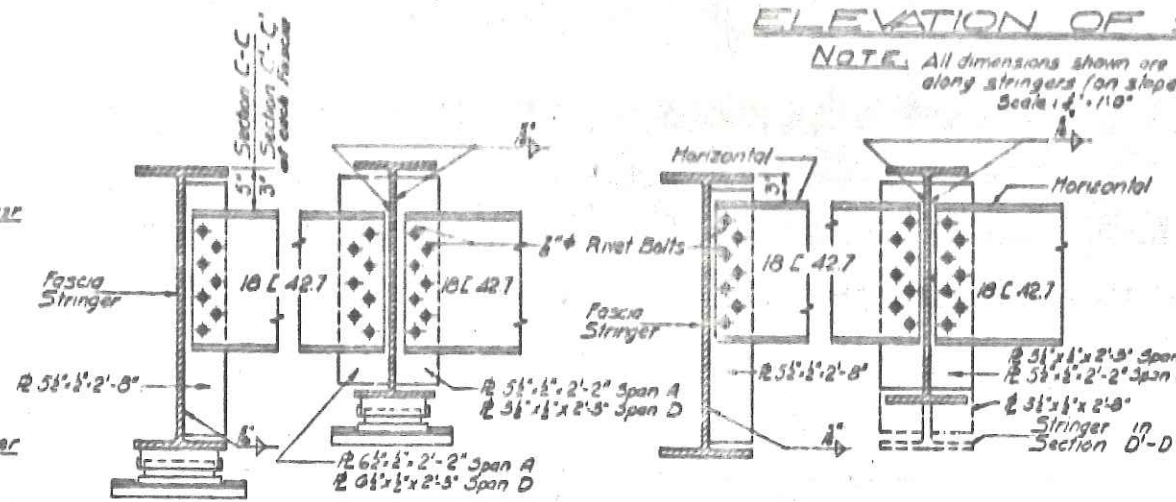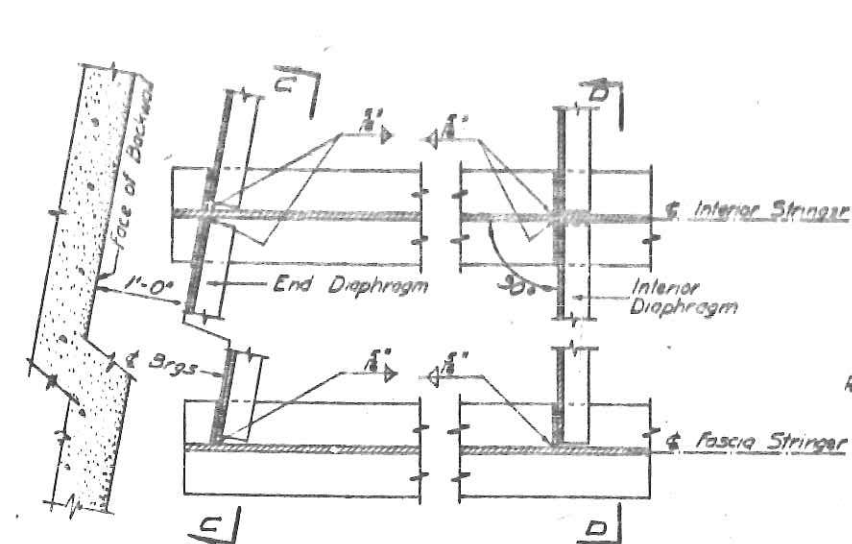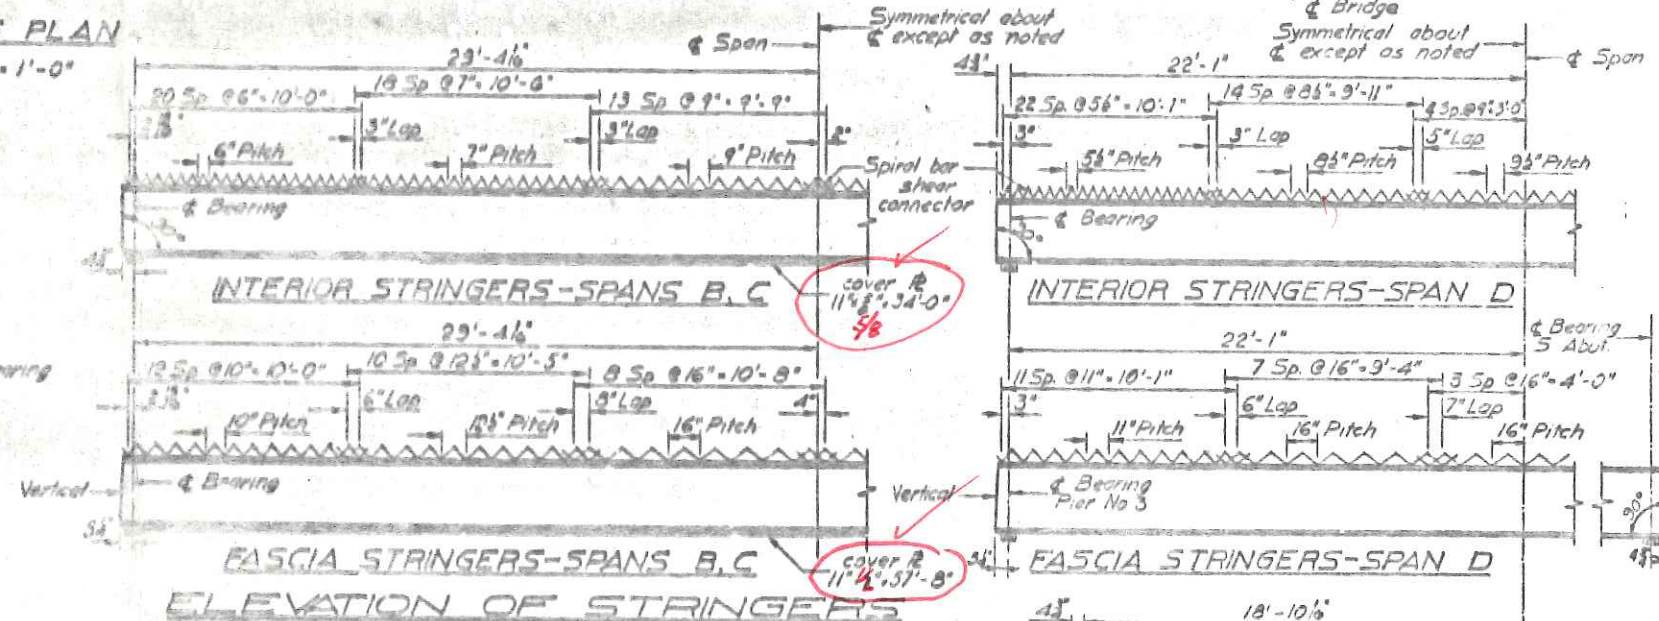

SECTION C-C SIMILAR &amp; AS NOTED TYPICAL END DIAPHRAGM

SECTION D-D' SIMILAR &amp; AS NOTED TYPICAL INTERMEDIATE DIAPHRAGM

CAMBER				
Span	Stringer	Dead Ld	Vert Cur	Total
A	Fascia	1/8"	1/8"	1/4"
	Interior	1/8"	1/8"	1/4"
B	Fascia	1/8"	1/8"	1/4"
	Interior	1/8"	1/8"	1/4"
C	Fascia	1/8"	1/8"	1/4"
	Interior	1/8"	1/8"	1/4"
D	Fascia	1/8"	1/8"	1/4"
	Interior	1/8"	1/8"	1/4"









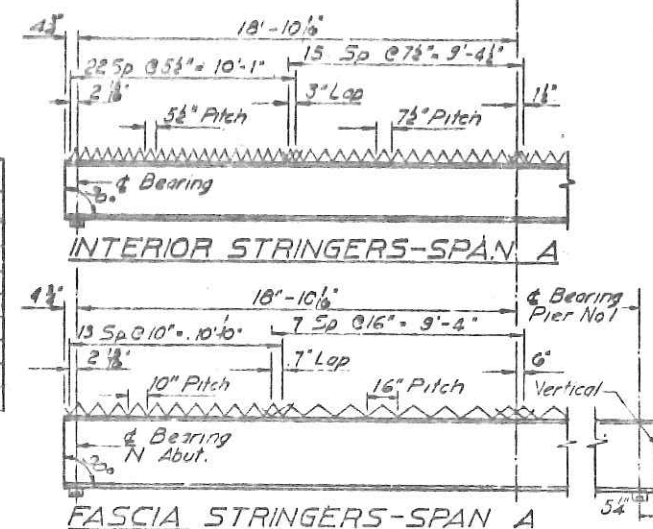


Notes: Work this Sheet with Sheet No. T7. All Material Structural Carbon Steel, Item 29, except as noted.

✓ PE 60047  
11-12-92




COUNTY	SHEET NO.	TOTAL SHEETS
ONEIDA	43	74
N.Y. STATE THRUWAY — MOHAWK SECT. SUB-DIV. 7		
WESTMORELAND TO WHITESBORO		

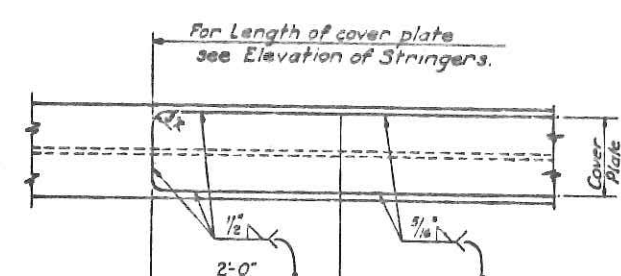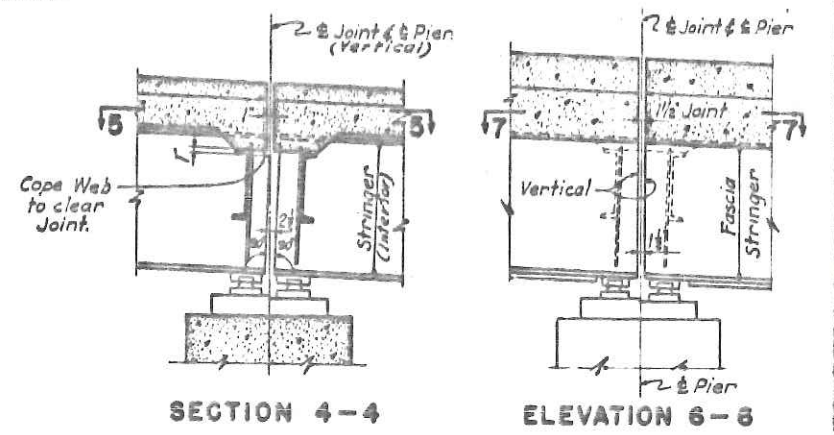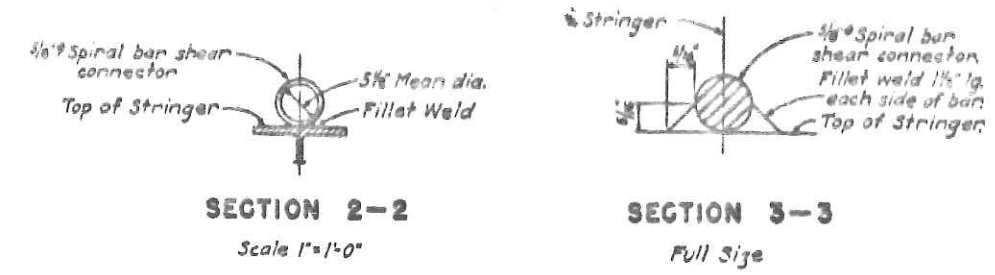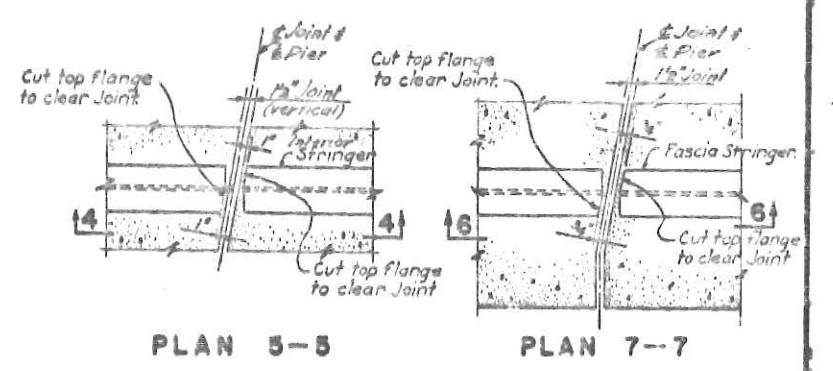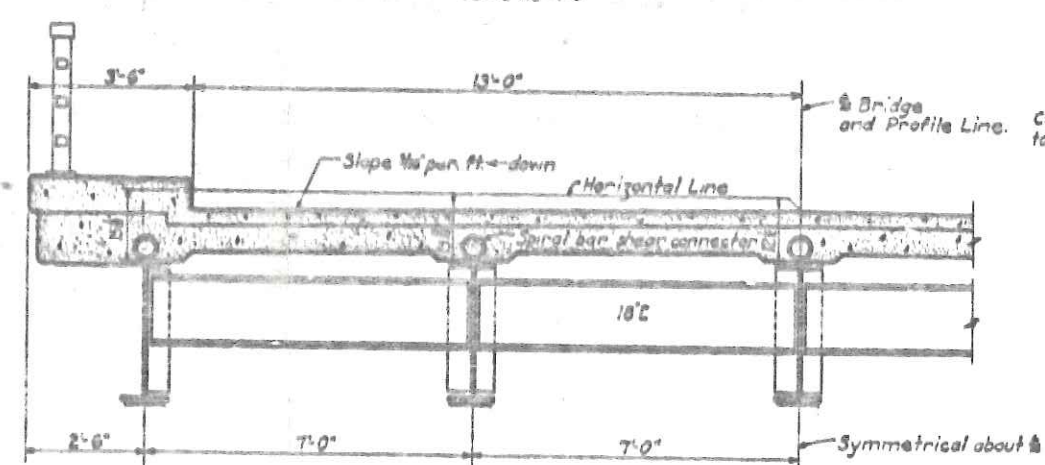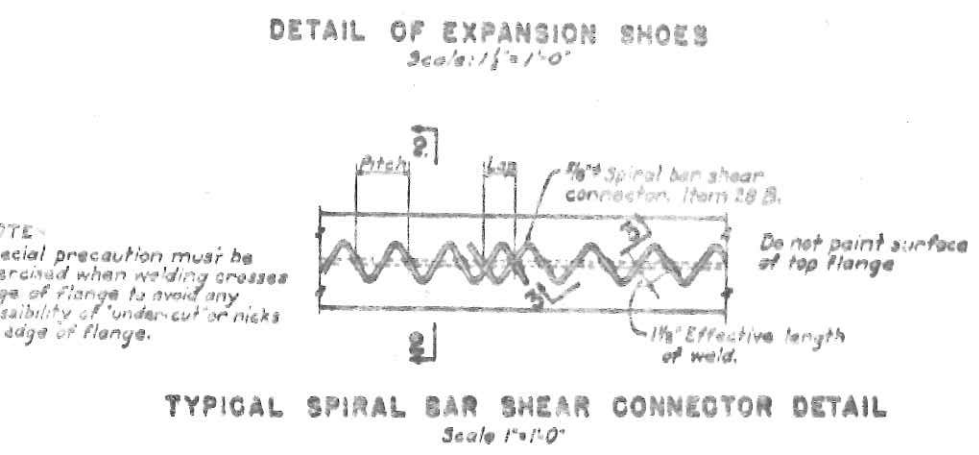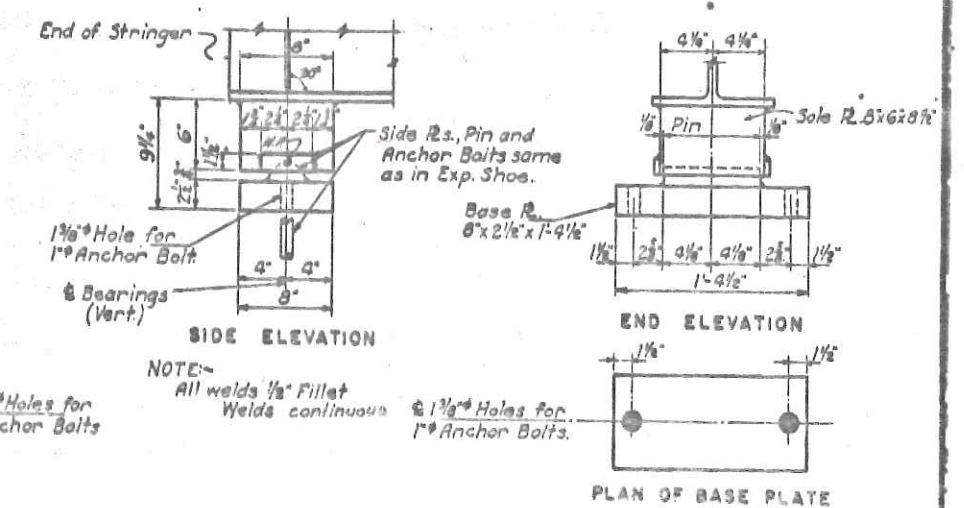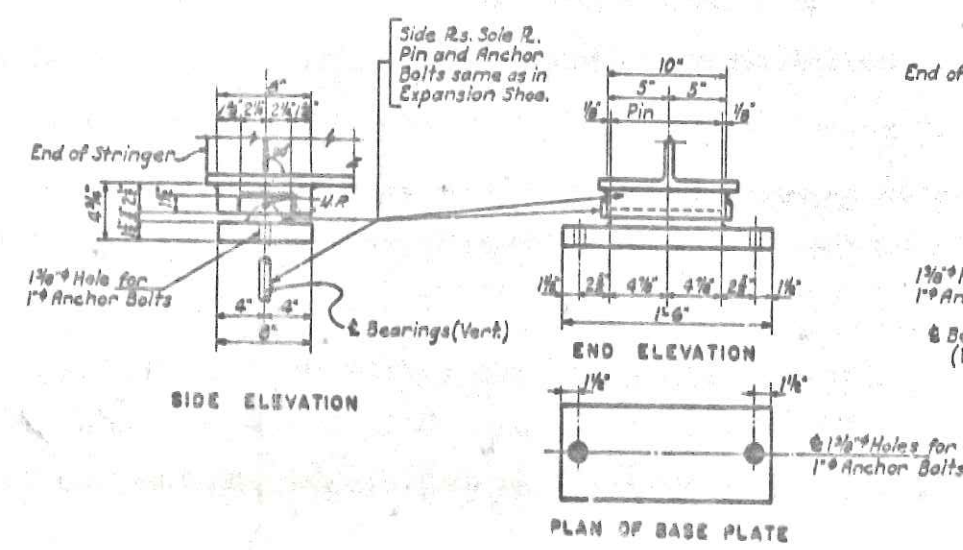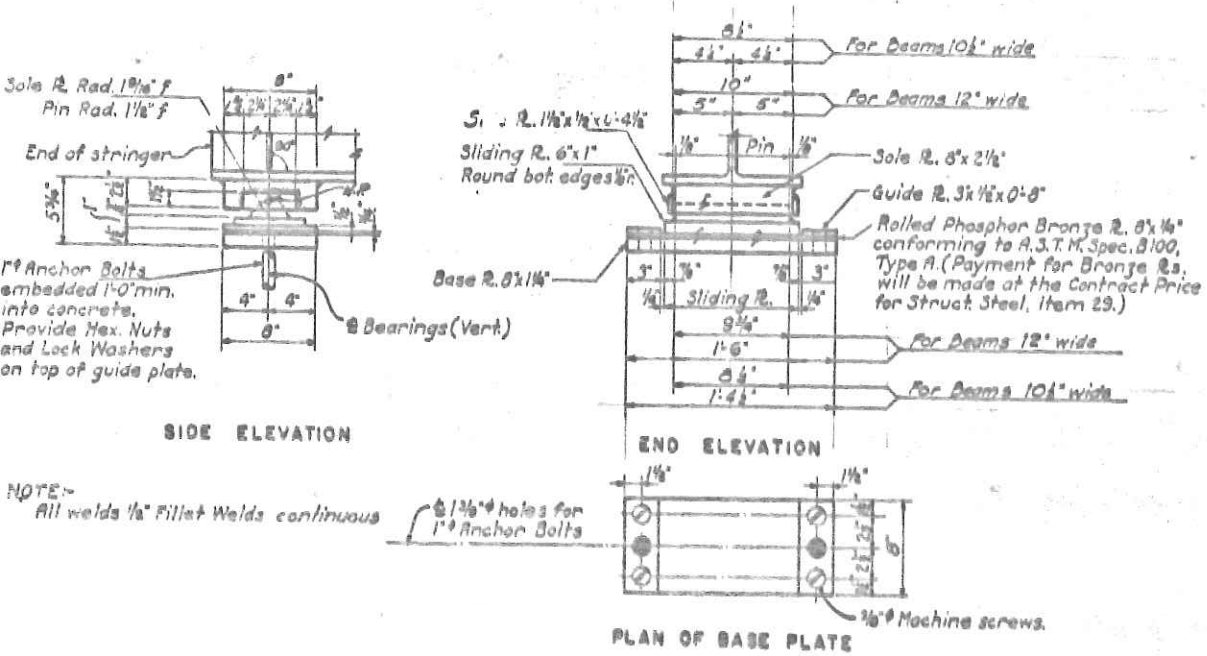


**TYPICAL DETAILS OF ENDS OF STRINGERS AT PIERS**  
Scale: 1/2" = 1'-0"



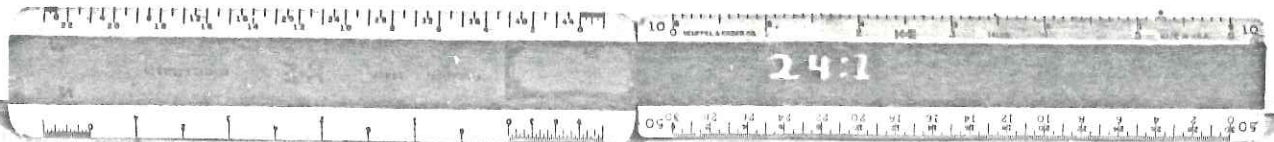


M.T. 52-12 S.T. 52-26

COUNTY	SHEET NO.	TOTAL SHEETS
ONEIDA	44	74
N.Y. STATE THRUWAY — MOHAWK SECT. SUB-DIV. 7		
WESTMORELAND TO WHITESBORO		

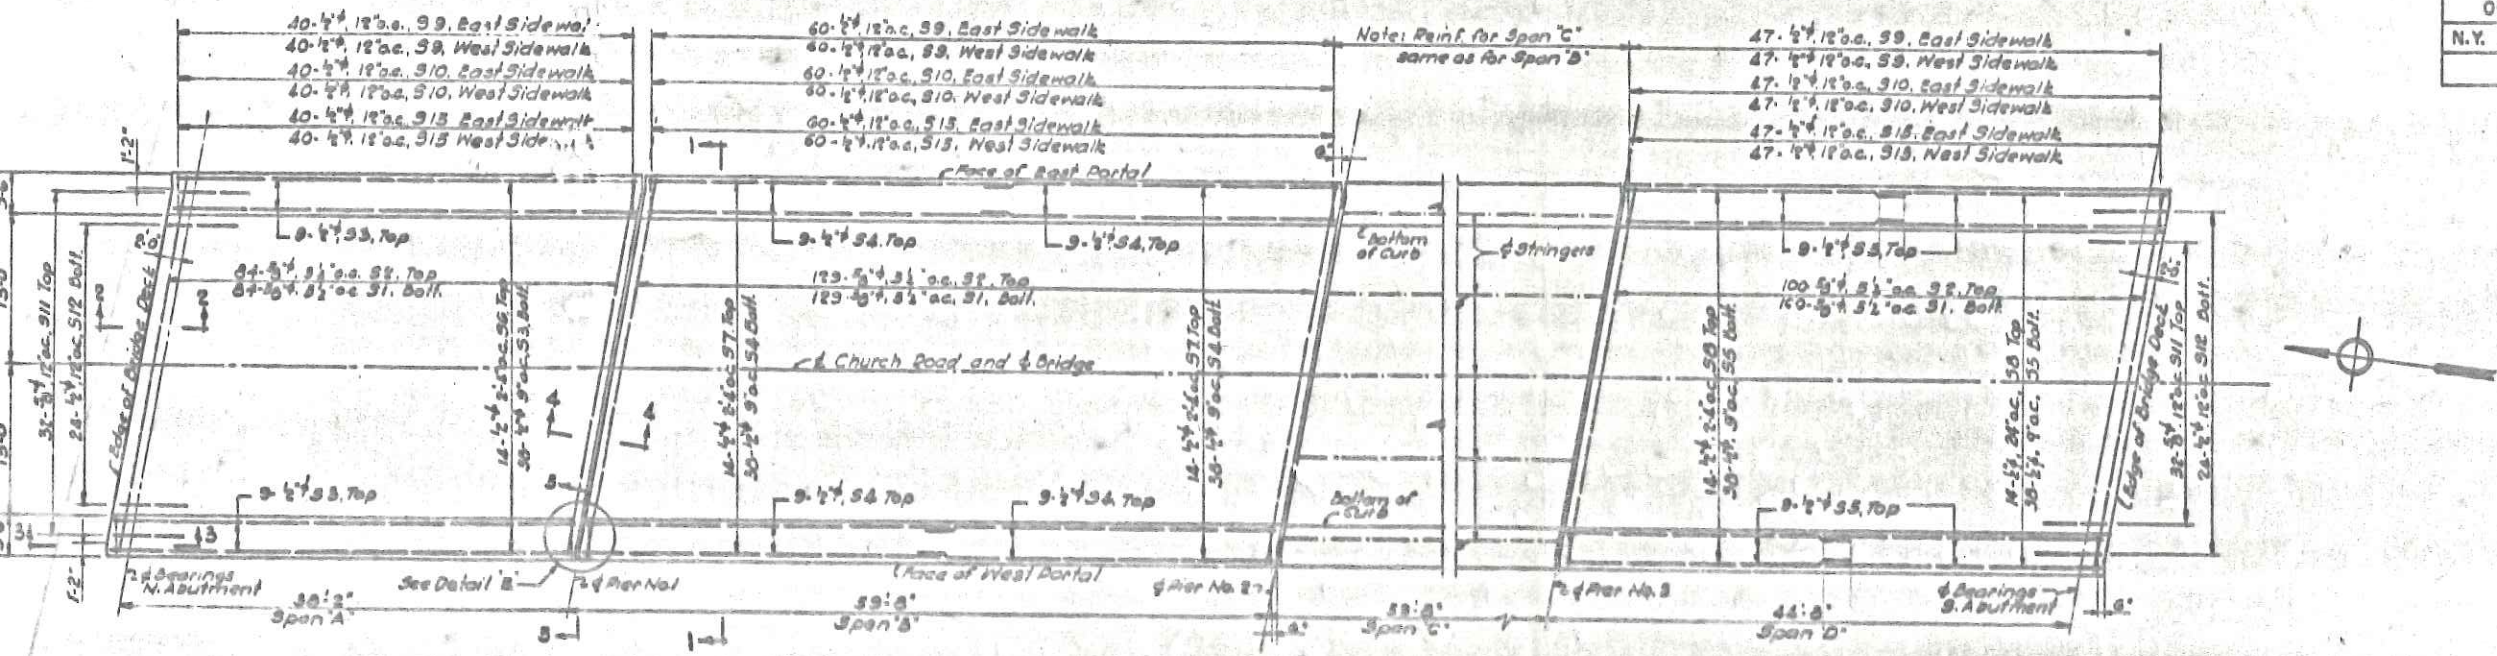


PLAN OF DECK SLAB  
Scale: 1/8" = 1'-0"

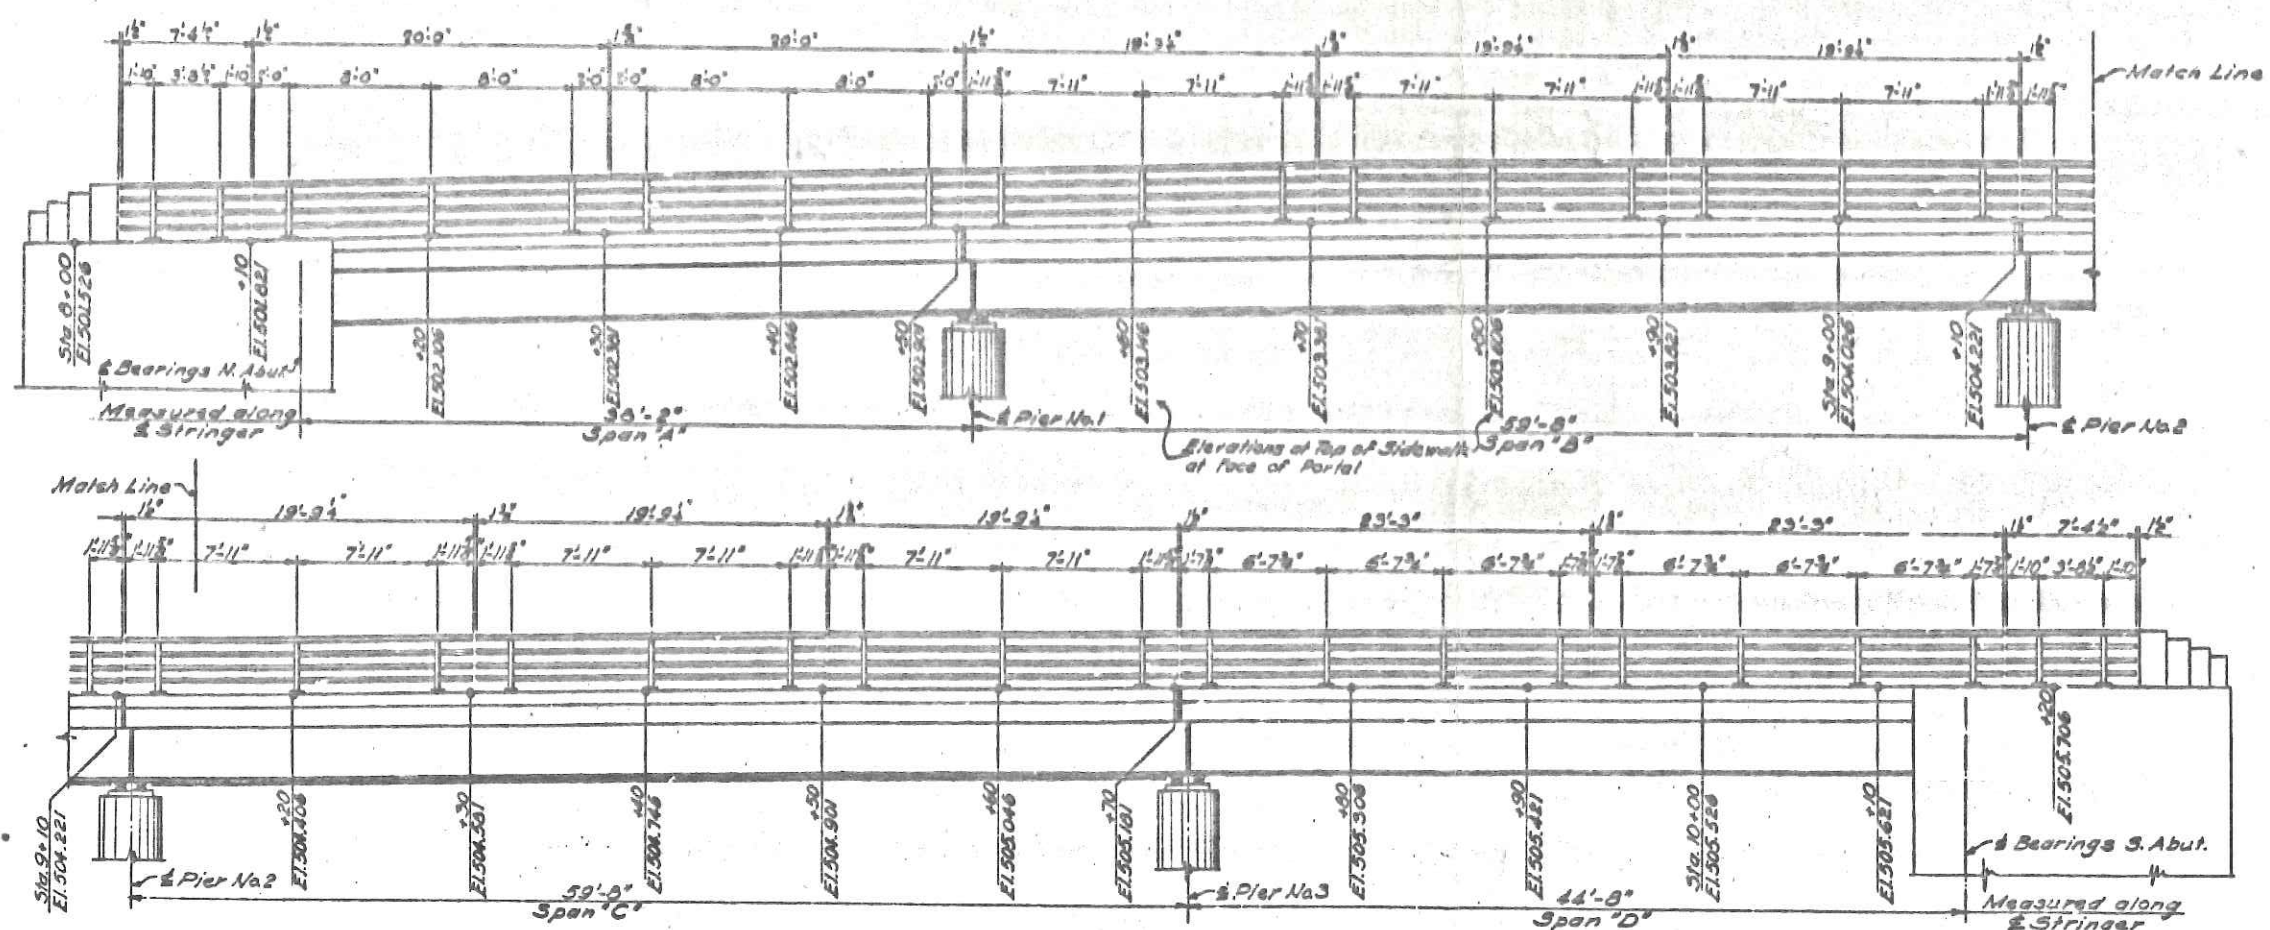


Notes: Work this Sheet with Sheet No. T9.  
For typical Plan View of Railing Posts on Bridge Deck see Detail 'E', Sheet No. T9.  
For typical Plan View of Railing Posts on Abutment Wings see Sheet No. T3.




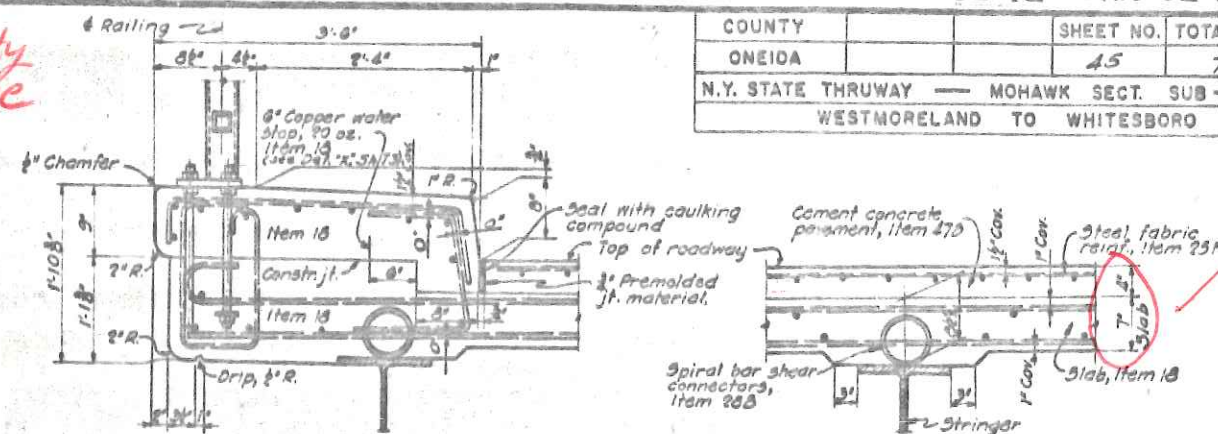


DETAIL B  
TYPICAL DETAIL OF SLAB

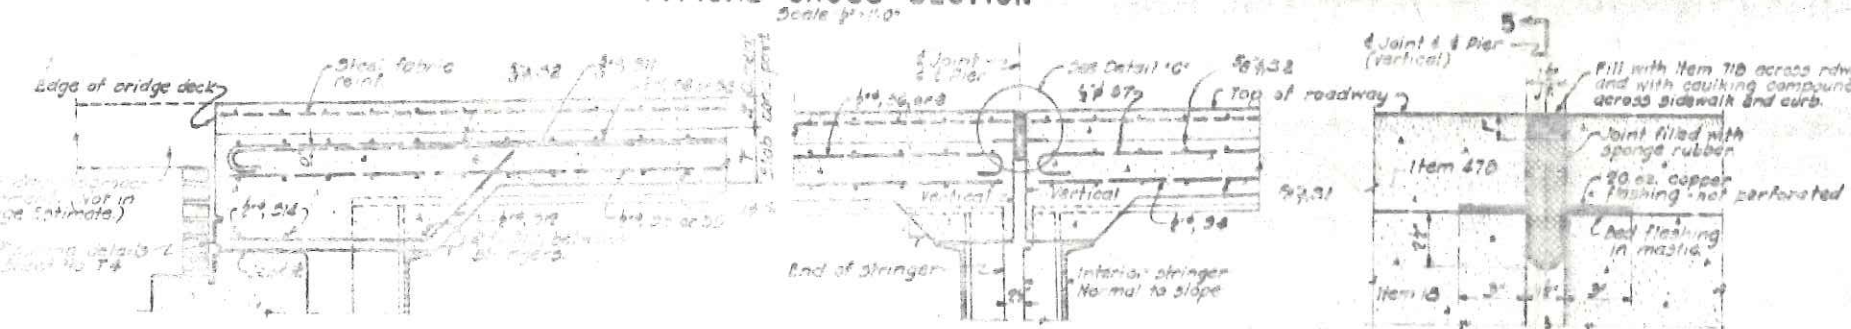


DETAIL C

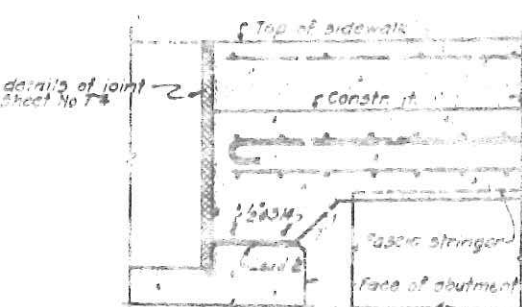


SECTION 3-3  
DETAILS OF SLAB  
AT ABUTMENT  
*Scale 1/4" = 1'-0"*

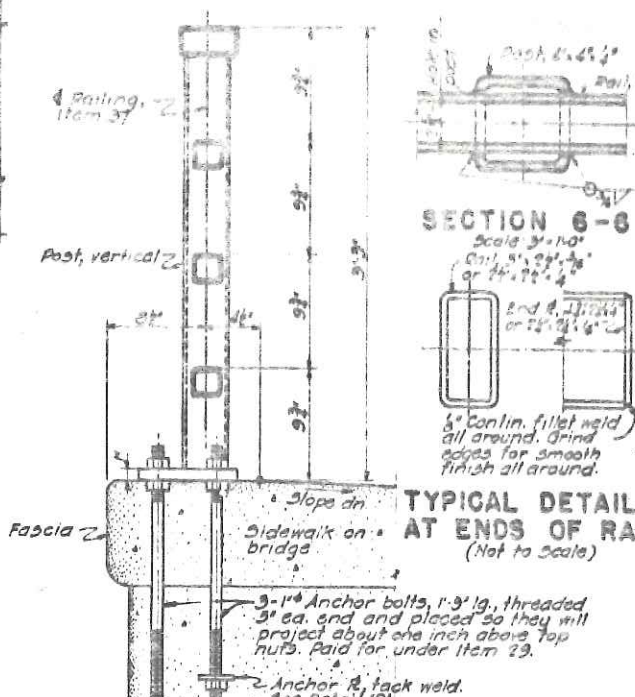


**TYPICAL DETAILS  
AT ENDS OF RAIL**  
(Not to Scale)

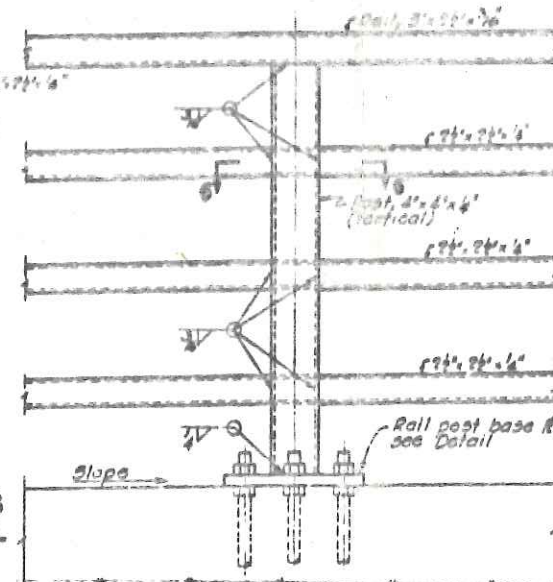


TYPICAL DETAIL OF RAILING  
Scale: 1/2" = 1'-0"

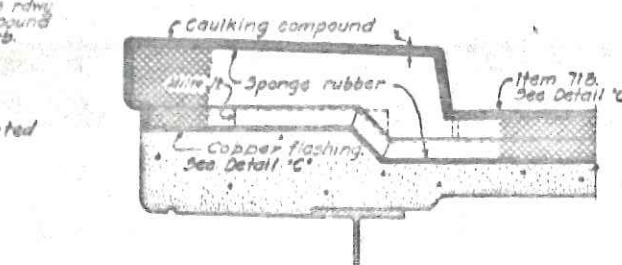

SECTION 6-5  
Scale: 1" = 150'

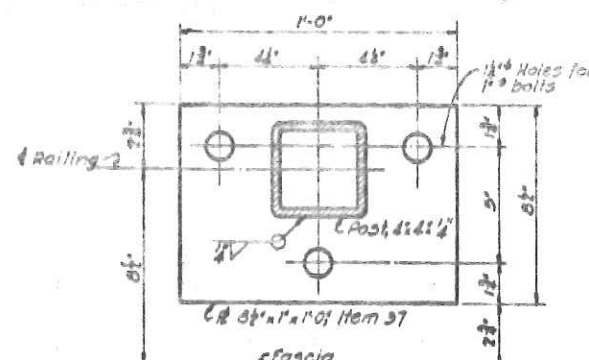

TYPICAL BASE  $\frac{1}{2}$  FOR RAILING POST  
Scale: 3" = 1'-0"

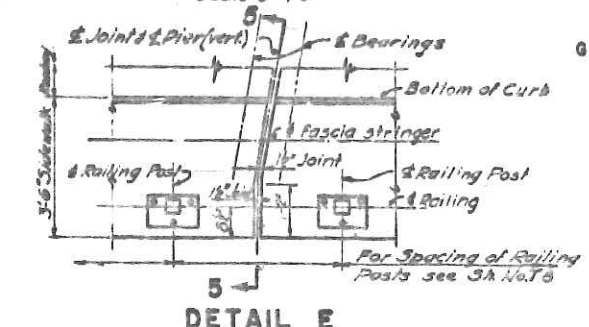

DETAIL B

Bottom transverse slab steel shall be placed in, or threaded thru the spiral bar shear connectors at such intervals as to achieve as uniform a spacing as possible. This spacing shall have an average value of that specified on drawings. For notes on caulking compound, sponge rubber, flashing and prepacked joint material, see General Notes, Sheet No. T-2.

All reinforcing bars to be lapped forty five (45) diameters unless otherwise noted.

## CONSTRUCTION PROCEDURES

1. Set railing anchor bolts, and pour concrete slab.
2. Apply two (2) coats of waterproofing oil to top of slab.
3. Lay 1/2" cement concrete pavement.
4. Place lower nuts on upper ends of anchor bolts.
5. Place railing base plates on lower nuts to bring bottom of plates to sidewalk level and railing posts to true vertical.
6. Place upper nuts on anchor bolts and tighten down plates.
7. Pour sidewalk to proper line and grade.

## NOTES FOR RAILING

Dimensions for tubing are outside dimensions.  
Shop or field welding may be used in fabrication of railing.  
Since the finished railings must meet the requirements of fit, alignment, grade and verticality of posts to the full satisfaction of the Engineer, it is suggested that complete field measurements be made before any shop fabrication work is performed.  
All railings are to be fabricated and erected so that rails are parallel to each other and to the top of fascia and the posts are true vertical.  
Tubular rails and base plates and, also, posts are to be paid for under item 37. Anchor bolts, nuts and anchor plates to be paid for under item 29.

## GENERAL NOTES:

Work this Sheet with Sheet No. 79.

✓  
RUB  
PE 60047  
1-12-92



## SUPERSTRUCTURE - BAR LIST

MARK	SIZE	NO.	LENGTH	TYPE	A	B	C	D	LOCATION
P1	3/4"	442	32'-10"	3/n					Transv. Bars, bolt of Slab - All Spans
P2	3/4"	442	33'-11"	7	0'-10"	32'-3"	0'-5"	0'-10"	Transv. Bars, top of Slab - All Spans
P3	3/4"	36	39'-10"	3/n					Longit. Bars, bolt of Slab & top of Slab - Span D
P4	3/4"	224	30'-8"	3/n					Longit. Bars, bolt of Slab & top of Slab - Span D
P5	3/4"	112	24'-2"	3/n					Long. Bars, L. of Slab & top of Slab - Span D
P6	3/4"	14	40'-10"	1	0'-8"	39'-8"	0'-4"	0'-8"	Longit. Bars, top of Slab - Span D
P7	3/4"	56	31'-2"	1	0'-8"	30'-6"	0'-4"		Longit. Bars, top of Slab - Spans B & C
P8	3/4"	28	24'-3"	1	0'-8"	24'-0"	0'-4"		Longit. Bars, top of Slab - Span D
P9	3/4"	414	4'-3"	II	0'-6"	3'-8"	0'-9"	0'-1"	Transv. Bars, top of Slab - All Spans
P10	3/4"	414	5'-2"	II					Hoops at Ends of Sidewalk - All Spans
P11	3/4"	64	6'-0"	1	0'-10"	5'-2"	0'-5"		Longit. Bars, top of Slab - Spans A & D
P12	3/4"	40	3'-5"	IX	2'-1"	1'-8"	0'-10"		Longit. Bars - Haunch - At Abutments
P13	3/4"	8	8'-10"	3/n					Transv. Bars - bolt of Haunch - At Abutments
P14	3/4"	4	32'-10"	3/n					Transv. Bars - bolt of Haunch - At Abutments
P15	3/4"	414	3'-5"	II	1'-3"	1'-4"	0'-10"	0'-11"	Dowels - Sidewalk - All Spans

NORTH & SOUTH ABUTMENTS - BAR LIST  
TOTAL FOR TWO ABUTMENTS

P1	3/4"	108	13'-5"	1	1'-0"	12'-5"	0'-6"		Vert. Piles, N. & S. Abutments
P2	3/4"	34	17'-5"	1	1'-0"	16'-5"	0'-6"		Battered Piles - N. Abutment
P3	3/4"	34	16'-5"	1	1'-0"	15'-5"	0'-6"		Battered Piles - S. Abutment
P4	3/4"	439	2'-10"	II	0'-9"	0'-5"			Ties for Piles - N. & S. Abutments
P5	3/4"	108	5'-2"	3/n					Hor. Tie Bars, Footing - Both Abutments
P6	3/4"	16	36'-9"	3/n					Hor. Bars - Footing - Both Abutments
P7	3/4"	40	16'-11"	3/n					Hor. Bars - Footing - Both Abutments
P8	3/4"	8	0'-9"	3/n					Hor. Bars - Footing - Both Abutments
P9	3/4"	64	8'-7"	3/n					Hor. Bars - Footing - Both Abutments
P10	3/4"	40	7'-11"	3/n					Hor. Bars - Footing - Both Abutments
P11	3/4"	36	5'-6"	3/n					Hor. Bars - Footing - Both Abutments
P12	3/4"	28	3'-10"	3/n					Hor. Bars - Footing - Both Abutments
P13	3/4"	20	10'-11"	3/n					Hor. Bars - Footing - Both Abutments
P14	3/4"	20	11'-1"	3/n					Hor. Bars - Footing - Both Abutments
P15	3/4"	20	10'-11"	3/n					Hor. Bars - Footing - Both Abutments
P16	3/4"	20	11'-0"	3/n					Hor. Bars - Footing - Both Abutments
P17	3/4"	8	31'-6"	3/n					Hor. - Rear of Backwall
P18	3/4"	8	6'-2"	1					Hor. - Front of Backwall
P19	3/4"	28	5'-3"	1	0'-8"	4'-7"	0'-4"		Hor. - E. Wing, N. Abut. & E. Wing, S. Abut.
P20	3/4"	16	4'-1"	3/n					Hor. - E. Wing, N. Abut. & E. Wing, S. Abut.
P21	3/4"	8	10'-5"	II	2'-0"	4'-3"	3'-9"	0	Hor. - E. Wing, N. Abut. & E. Wing, S. Abut.
P22	3/4"	16	5'-11"	3/n					Hor. - E. Wing, N. Abut. & E. Wing, S. Abut.
P23	3/4"	8	13'-0"	II	2'-9"	4'-8"	5'-7"	0	Hor. - E. Wing, N. Abut. & E. Wing, S. Abut.
P24	3/4"	50	10'-5"	II	3'-1"	1'-10"			Hor. - E. Wing, N. Abut. & E. Wing, S. Abut.
P25	3/4"	8	9'-10"	3/n					Bent Stirrups - Pedestals
P26	3/4"	12	9'-10"	3/n					Hor. - Rear - E. Wing, N. Abut. & E. Wing, S. Abut.
P27	3/4"	12	9'-10"	3/n					Hor. - Front - E. Wing, N. Abut. & E. Wing, S. Abut.
P28	3/4"	8	9'-10"	3/n					Hor. - E. Wing, N. Abut. & E. Wing, S. Abut.
P29	3/4"	50	6'-8"	II	1'-5"	4'-7"	0'-8"	0'-1"	Transv. in Sidewalk
P30	3/4"	8	11'-4"	3/n					Hor. - Rear - E. Wing, N. Abut. & E. Wing, S. Abut.
P31	3/4"	12	11'-4"	3/n					Hor. - Front - E. Wing, N. Abut. & E. Wing, S. Abut.
P32	3/4"	8	11'-4"	3/n					Hor. - E. Wing, N. Abut. & E. Wing, S. Abut.
P33	3/4"	8	1'-9"	3/n					Hor. - E. Wing, N. Abut. & E. Wing, S. Abut.
P34	3/4"	4	36'-9"	II	33'-5"	3'-6"	0'-7"		Hor. Bars - Footing - Both Abutments
P35	3/4"	40	8'-8"	3/n					Vert. Dowels in Pylons
P36	3/4"	40	4'-9"	3/n					Hor. Dowels in Pylons

## PIER NO. 1 - BAR LIST


MARK	SIZE	NO.	LENGTH	TYPE	A	B	C	D	LOCATION
P1	1 1/2"	10	36'-5"	3/n					Longit. Bars in Footing - Bottom
P2	1 1/2"	10	36'-5"	3/n					Longit. Bars in Footing - Top
P3	3/4"	40	3'-8"	3/n					Transv. Bars in Footing - Top & Bottom
P4	1 1/2"	26	8'-4"	1	1'-9"	6'-7"	0'-11"		Dowels in Footing
P5	1 1/2"	13	7'-7"	1	1'-6"	6'-1"	0'-10"		Dowels in Footing
P6	1 1/2"	26	23'-8"	3/n					Vert. Bars in Columns
P7	1 1/2"	13	23'-8"	3/n					Vert. Bars in Columns
P8	3/4"	3	780'-0"	III	19'-0"	3'-0"			Spirals in Columns
P9	1 1/2"	4	33'-0"	3/n					Top Strut - Bottom
P10	1 1/2"	6	10'-6"	3/n					Top Strut - Top
P11	1 1/2"	2	36'-4"	III	2'-0"	3'-2"	26'-0"	2'-0"	Top Strut - Top
P12	1 1/2"	2	39'-4"	III	2'-0"	3'-2"	29'-0"	2'-0"	Top Strut - Top
P13	1 1/2"	3	11'-0"	3/n					Top Strut - Top
P14	3/4"	24	11'-3"	II	2'-2"	3'-2"			Top Strut - Stirrups
P15	3/4"	4	29'-11"	3/n					Top Strut - Sides
P16	3/4"	10	9'-10"	III	2'-6"	4'-10"	3'-0"		Top Strut at Ends
P17	3/4"	40	2'-6"	II	0'-6"	2'-0"			Top Strut - Under Pads
P18	3/4"	3	9'-3"	II	2'-2"	2'-2"			Top Strut - Under Pads

## PIERS NO. 2 &amp; 3 - BAR LIST - TOTAL FOR TWO PIERS


P101	1 1/2"	20	36'-5"	3/n					Longit. Bars in Footing - Bottom
P102	1 1/2"	20	36'-5"	3/n					Longit. Bars in Footing - Top
P103	3/4"	80	3'-8"	3/n					Transv. Bars in Footing - Top & Bottom
P104	1 1/2"	26	8'-4"	1	1'-9"	6'-7"	0'-11"		Dowels in Footing
P105	1 1/2"	26	7'-7"	1	1'-6"	6'-1"	0'-10"		Dowels in Footing
P106	1 1/2"	26	21'-5"	3/n					Vert. Bars in Columns
P107	1 1/2"	26	21'-5"	3/n					Vert. Bars in Columns
P108	3/4"	3	718'-0"	III	18'-1"	3'-0"			Spirals in Columns
P109	1 1/2"	8	33'-0"	3/n					Top Strut - Bottom
P110	1 1/2"	12	10'-5"	3/n					Top Strut - Top
P111	1 1/2"	4	36'-4"	III	2'-0"	3'-2"	26'-0"	2'-0"	Top Strut - Top
P112	1 1/2"	4	39'-4"	III	2'-0"	3'-2"	29'-0"	2'-0"	Top Strut - Top
P113	1 1/2"	6	11'-0"	3/n					Top Strut - Top
P114	3/4"	48	11'-3"	II	2'-2"	3'-2"			Top Strut - Stirrups
P115	3/4"	8	29'-11"	3/n					Top Strut - Sides
P116	3/4"	20	9'-10"	III	2'-6"	4'-10"	3'-0"		Top Strut at Ends
P117	3/4"	80	2'-6"	II	0'-6"	2'-0"			Top Strut - Under Pads
P118	3/4"	10	9'-3"	II	2'-2"	2'-2"			Top Strut - Under Pads

COUNTY	ONEIDA	SHEET NO.	46	TOTAL SHEETS	74
N.Y. STATE THRUWAY - MOHAWK SECT. 508 - DIV. 7					
WESTMORELAND TO WHITESBORO					


## BAR DETAILS

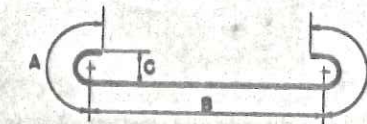


TYPE I

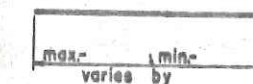


TYPE II

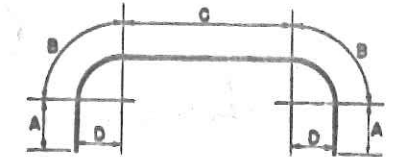


TYPE III

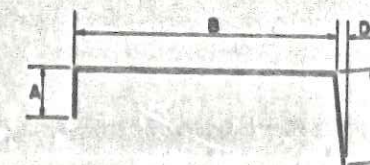


TYPE IV

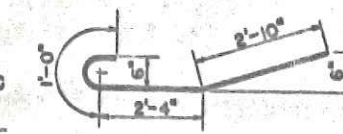


TYPE V

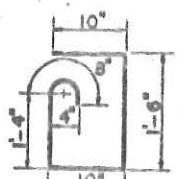

TYPE VI

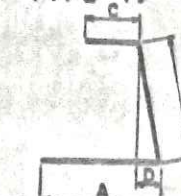


TYPE VII

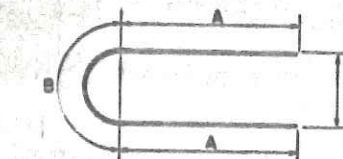


TYPE VIII




TYPE IX

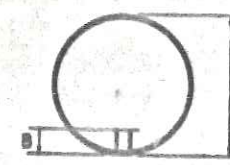


TYPE X

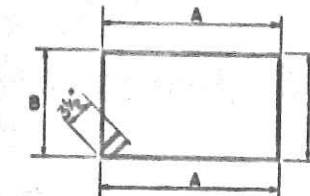

TYPE XI

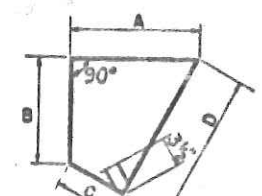

TYPE XII

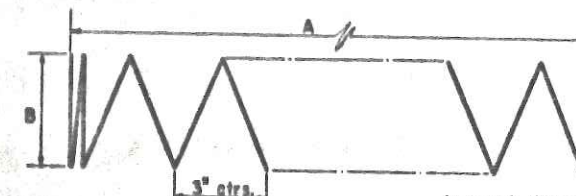


TYPE XIII

Note: If Spirals are made up of 2 or more bars, ends are to be butt welded together.


General note: All dimensions are measured along outside face or out to out of bars.



COUNTY	SHEET NO.	TOTAL SHEETS
ONEIDA	42	74
N.Y. STATE THRUWAY — MONAKA SECT. SUB-DIV. 7		
WESTMORELAND TO WHITEBORO		

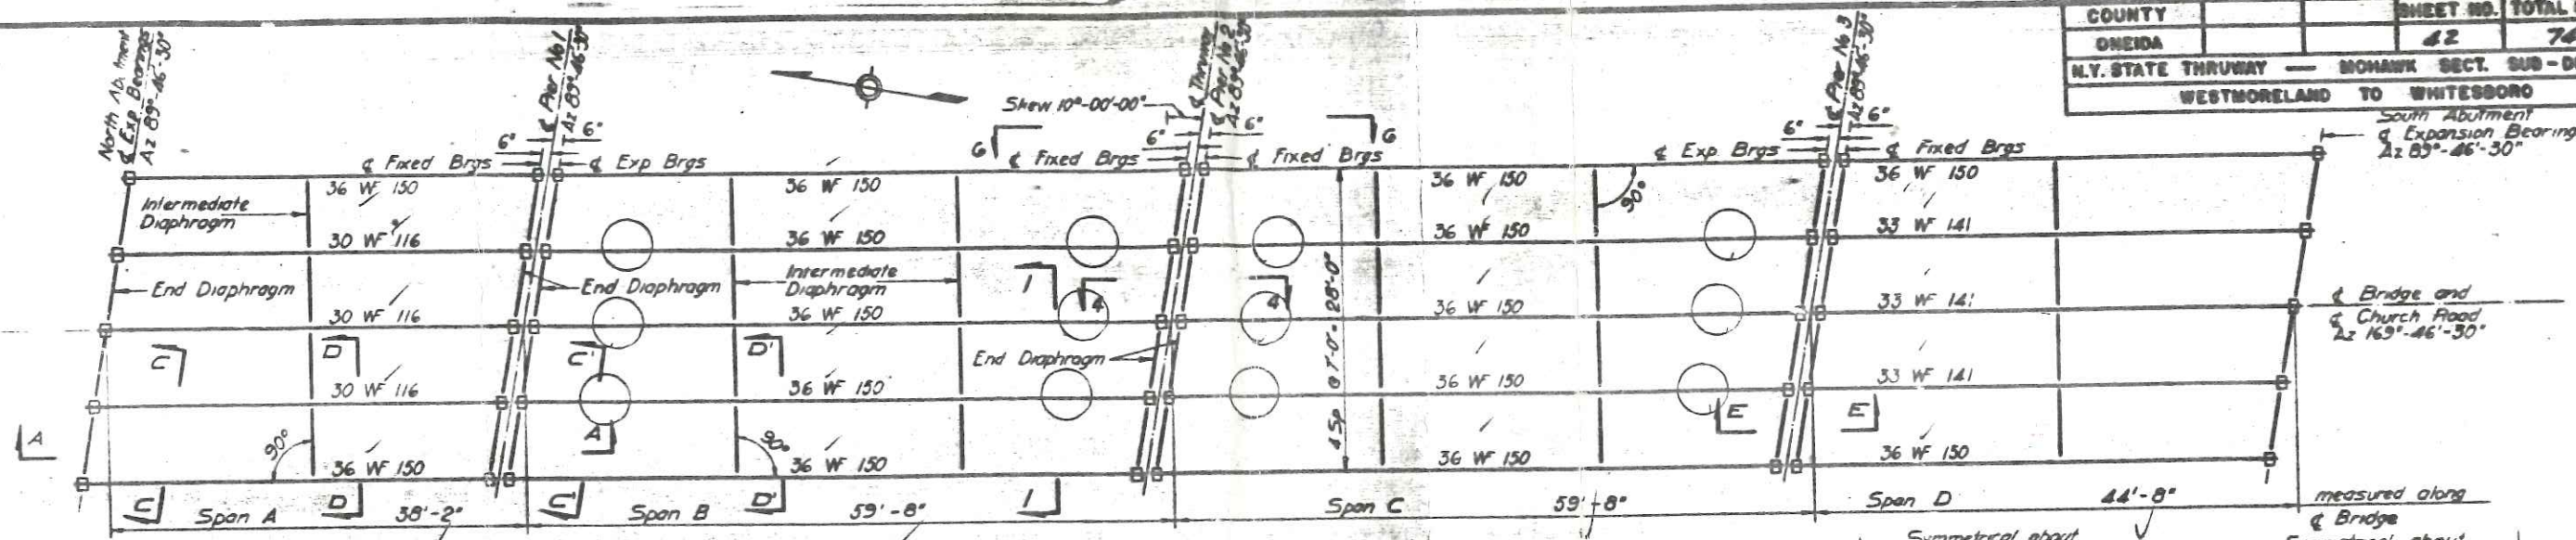


**FRAMING PLAN**  
Scale 1" = 1'-0"

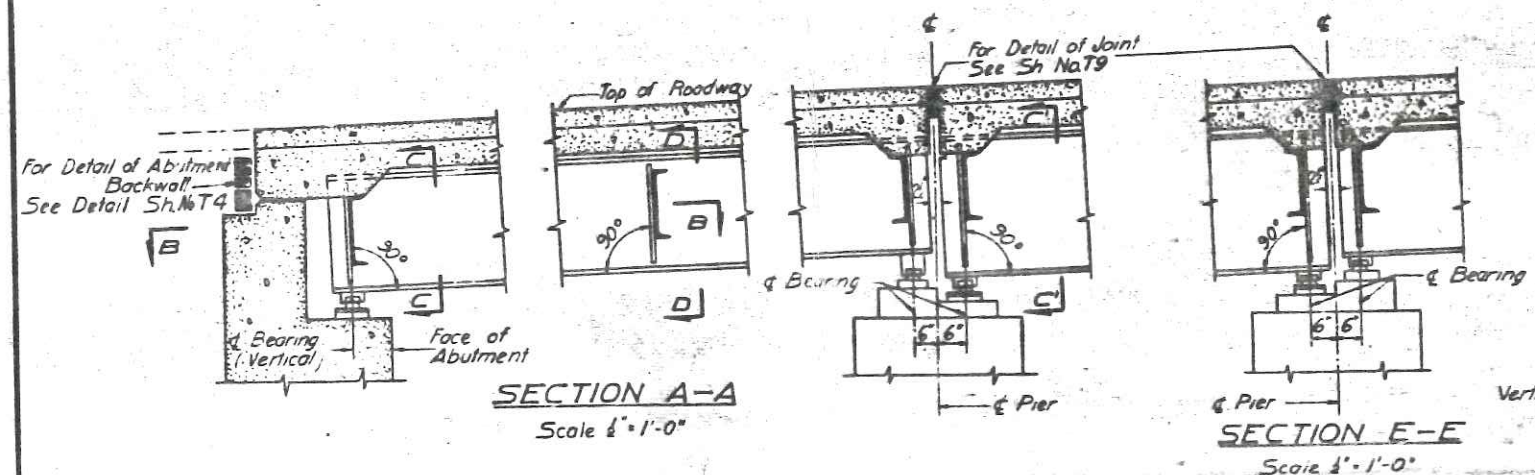


**SECTION A-A**  
Scale 1" = 1'-0"

**SECTION E-E**  
Scale 1" = 1'-0"

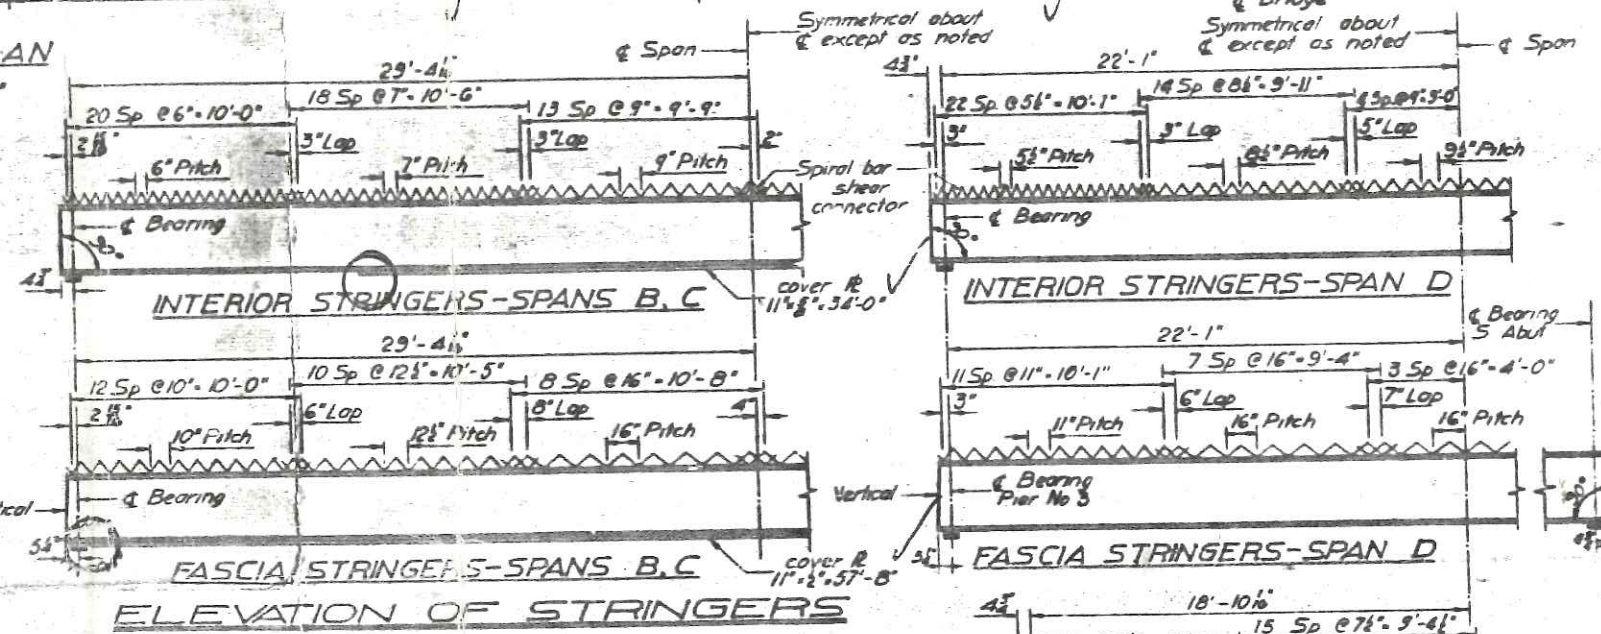


**ELEVATION OF STRINGERS**


NOTE: All dimensions shown are measured along stringers (on slope).  
Scale: 1" = 1'-0"

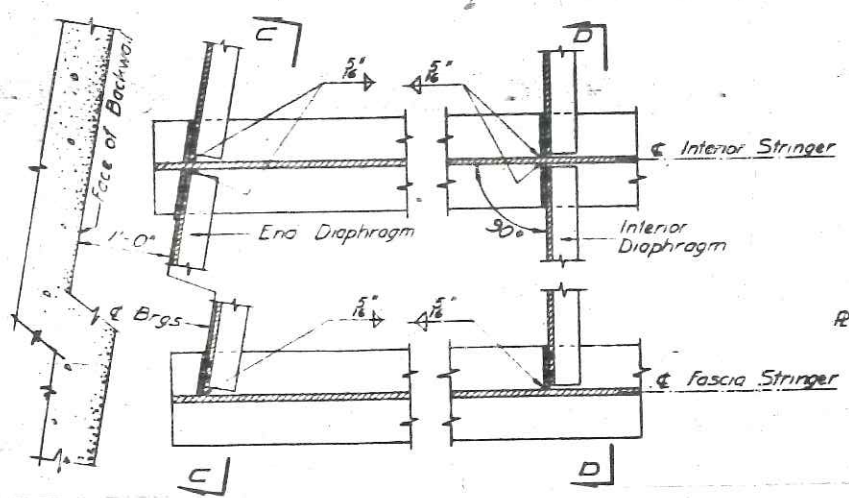

**SECTIONAL PLAN B-B**  
Scale 1" = 1'-0"

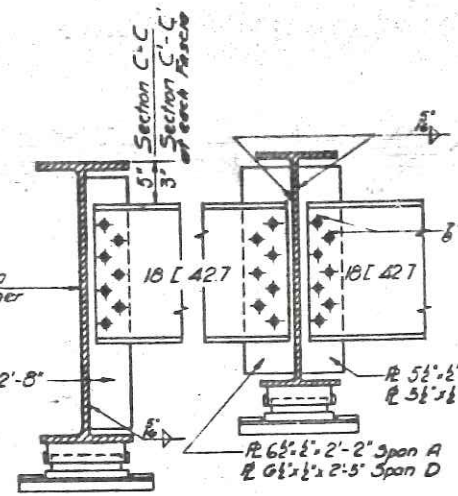


**SECTION C-C**  
TYPICAL END DIAPHRAGM  
Scale 1" = 1'-0"

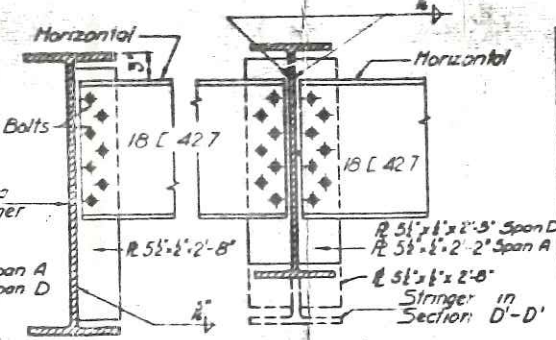

**SECTION D-D**  
TYPICAL INTERMEDIATE DIAPHRAGM  
Scale 1" = 1'-0"

CAMBER				
Span	Stringer	Dead Ld	Vert Cur	Total
A	Fascia	1/8"	1/8"	1/4"
	Interior	1/8"	1/8"	1/4"
B	Fascia	1/8"	1/8"	1/4"
	Interior	1/8"	1/8"	1/4"
C	Fascia	1/8"	1/8"	1/4"
	Interior	1/8"	1/8"	1/4"
D	Fascia	1/8"	1/8"	1/4"
	Interior	1/8"	1/8"	1/4"

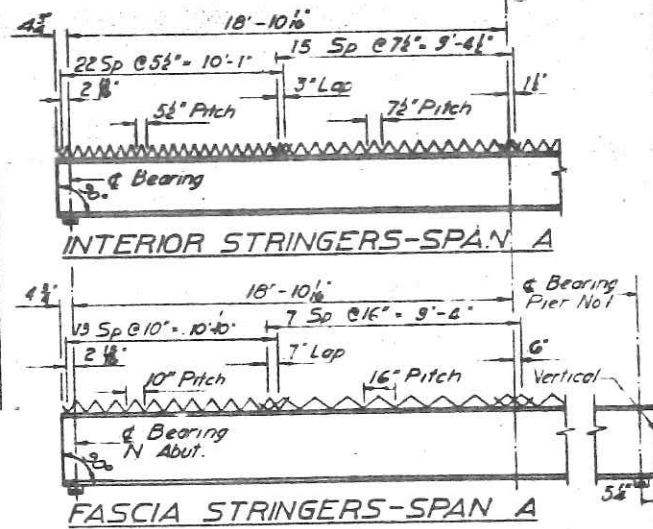

Notes: Work this Sheet with Sheet No. T7.  
All Material Structural Carbon Steel.  
Item 29, except as noted.  
All Stringers to be cambered for dead load plus the effect of vertical curvature of roadway profile.  
The Contractor may at his option, use 1/2" Field Rivets instead of the Rivet Bolts shown.

BY	DATE
MADE	7-19-52
TRACED	7-19-52
CHECKED	7-19-52

PREPARED AND RECOMMENDED  
AMMANN & WHITNEY, CONSULTING ENGINEERS  
NEW YORK STATE PROFESSIONAL ENGINEERS LICENSE NO. 14189

7-19-52  
DATE


BIN 5512980

CHURCH ROAD BRIDGE OVER  
N.Y. STATE THRUWAY  
STRUCTURAL STEEL DETAILS




M.T. 52-12 S.T. 52-26


COUNTY	SHEET NO.	TOTAL SHEETS
ONEIDA	45	74
N.Y. STATE THRUWAY — MOHAWK SECT. SUB-DIV. 7		
WESTMORELAND TO WHITESBORO		

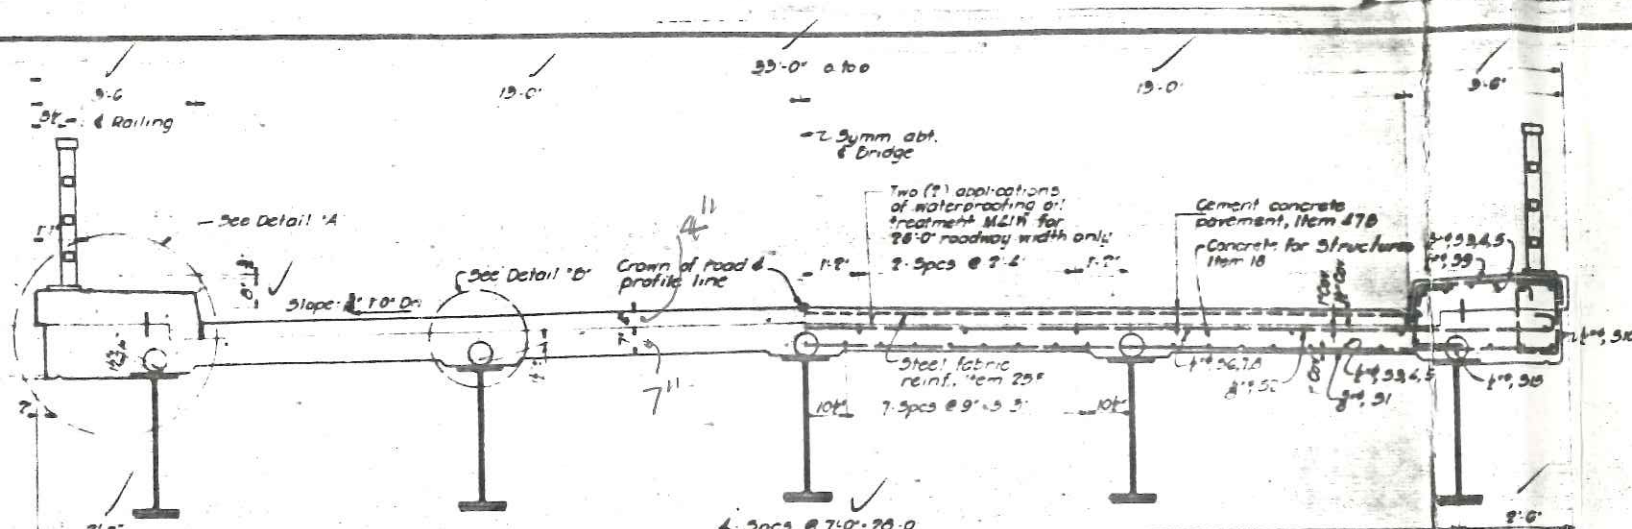


SECTION 1-1  
TYPICAL CROSS SECTION  
Scale 1"=10'-0"

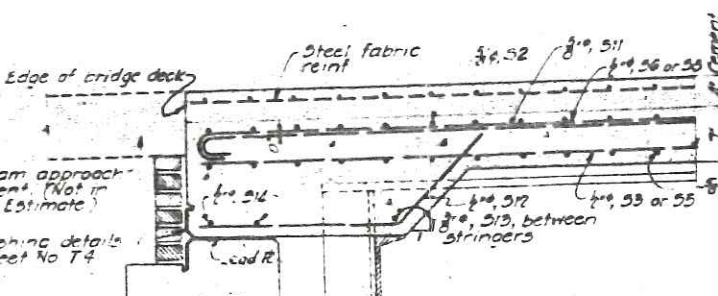


SECTION 2-2

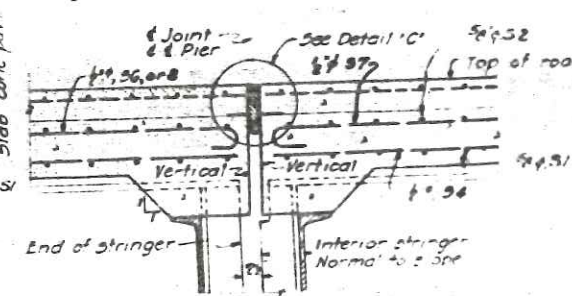


SECTION 4-4  
DETAILS OF SLAB AT PIER  
Scale 1"=10'-0"

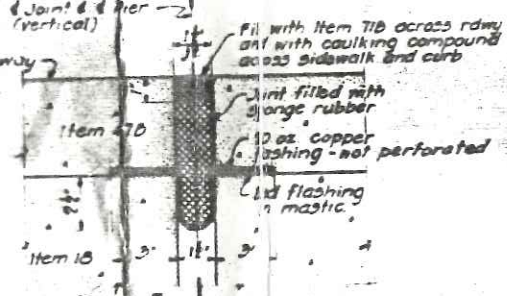


DETAIL C

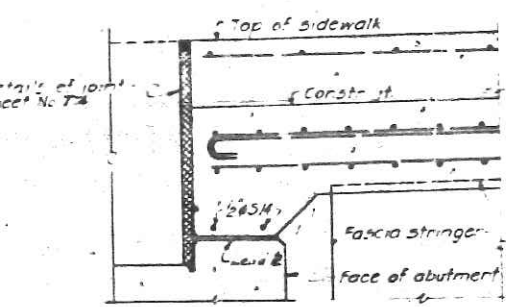


SECTION 3-3  
DETAILS OF SLAB  
AT ABUTMENT  
Scale 1"=10'-0"

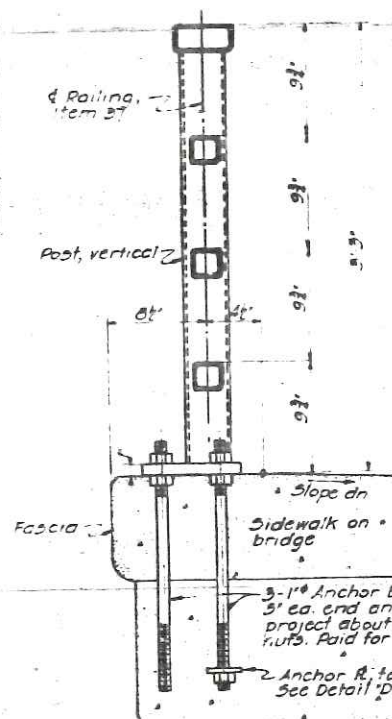


TYPICAL SECTION THRU RAILING  
Details shown for railing on bridge deck  
Railing on abutment similar

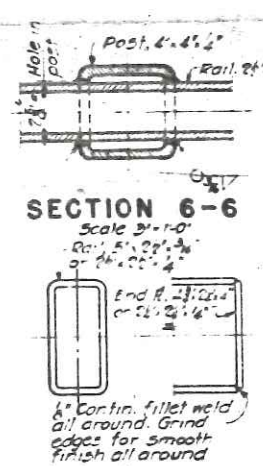


SECTION 6-6

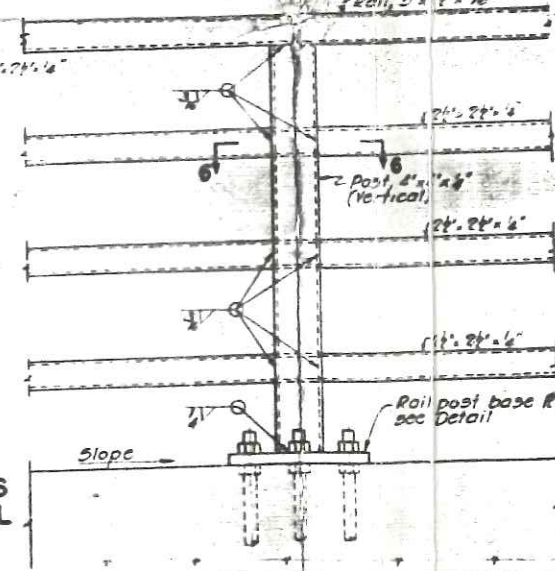

TYPICAL DETAIL OF RAILING  
Scale 1/8"=1'-0"

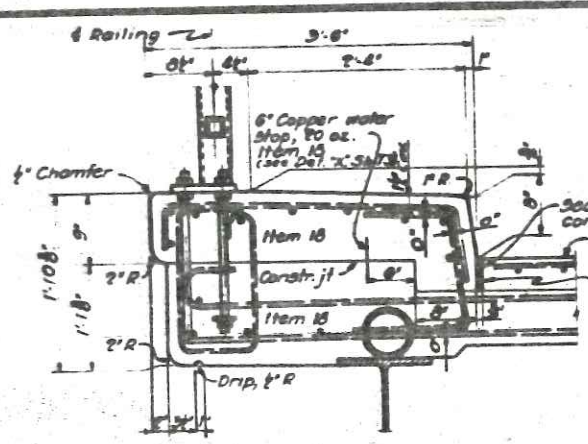

DETAIL A  
Scale 1"=1'-0"

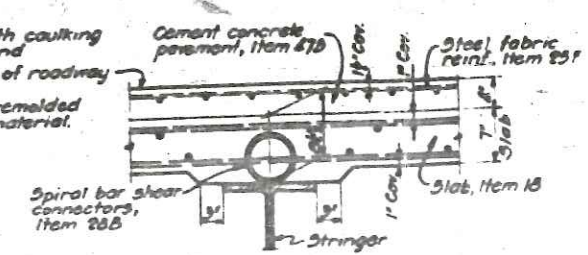

DETAIL B  
TYPICAL DETAIL OF SLAB  
Scale 1"=1'-0"

NOTES FOR SLAB

Bottom transverse slab steel shall be placed in, or threaded thru the spiral bar shear connectors at such intervals as to achieve as uniform a spacing as possible. This spacing shall have an average value of that specified on Drawings. For notes on caulking compound, sponge rubber, flashing and preformed joint material, see General Notes, Sheet No. T2.  
All reinforcing bars to be lapped forty (40) diameters unless otherwise noted.

CONSTRUCTION PROCEDURE


- 1- Set railing anchor bolts, and pour concrete slab.
- 2- Apply two (2) coats of waterproofing oil to top of slab.
- 3- Pour cement concrete pavement.
- 4- Place lower nuts on upper end of anchor bolts.
- 5- Place railing base plates on lower nuts to bring bottom of plates to sidewalk level and railing posts to true vertical.
- 6- Place upper nuts on anchor bolts and tighten down plates.
- 7- Pour sidewalk to proper line and grade.

NOTES FOR RAILING


Dimensions for tubing are outside dimensions. Shop or field welding may be used in fabrication of railing.  
Since the finished railings must meet the requirements of fit, alignment, grade and verticality of posts to the full satisfaction of the Engineer, it is suggested that complete field measurements be made before any shop fabrication work is performed.  
All railings are to be fabricated and erected so that rails are parallel to each other and to the top of fascia and the posts are true vertical.  
Tubular rails and base plates and, also, posts are to be paid for under Item 57. Anchor bolts, nuts and anchor plates to be paid for under Item 29.

GENERAL NOTES:

Work this Sheet with Sheet No. T6.

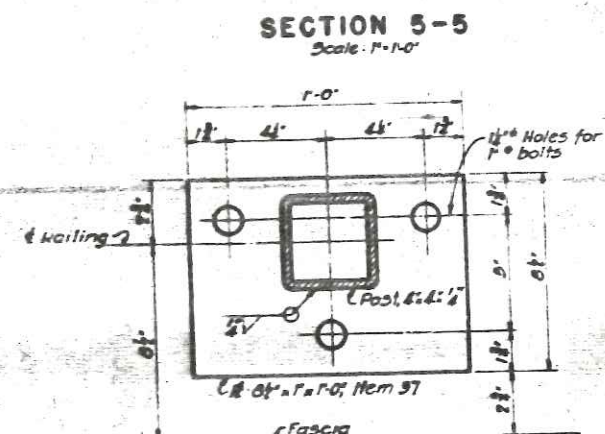

TYPICAL BASE & FOR RAILING POST  
Scale 3/4"=1'-0"

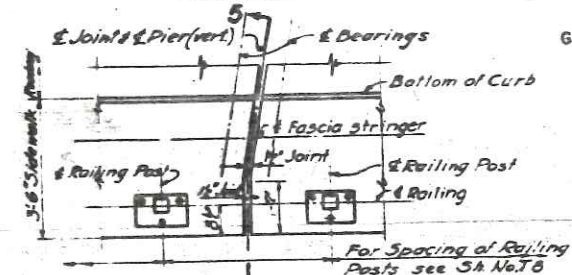

DETAIL E  
TYPICAL PLAN OF DECK AT PIER  
Scale 1/2"=1'-0"

DETAIL D  
TYPICAL ANCHOR PLATE  
Scale 3/4"=1'-0"

NO.	DATE
1	7-19-52
2	7-19-52
3	7-19-52

PREPARED AND RECOMMENDED  
AMMANN & WHITNEY, CONSULTING ENGINEERS

7-19-52

CHURCH ROAD BRIDGE OVER  
N. Y. STATE THRUWAY

DECK DETAILS BIN E517980

SHEET NO. T 9

B. Colwell  
PE 46031  
10.23.86  
J. Kai Wang  
PE 7221 NH  
10/15/90

MEAD  
PE 63767  
11/2/88