# NEW YORK STATE THRUWAY AUTHORITY DEPARTMENT OF ENGINEERING

ALBANY, NY MAY 22, 2024

#### AMENDMENT NO. 3 TO

CONTRACT TAS 24-20B D214978 REPLACEMENT OF THE I-90 BRIDGE OVER ORISKANY BOULEVARD (NY 69) AT MILEPOST 238.22 IN THE SYRACUSE DIVISION OF THE NEW YORK STATE THRUWAY IN ONEIDA COUNTY

## IN THE LETTING OF MAY 29, 2024

NOTE: This amendment shall be attached to and become a part of the Proposal for Contract TAS 24-20B.

#### **NOTICE**

For Electronic Bidders, the Project's amended EBSX file will automatically account for any necessary item changes (deletions, changes in quantities, or additions) that this Amendment may describe as being required regarding the project's estimated cost. Instructions to make physical changes to the Project Proposal's bid sheets are intended for "paper" Bidders who choose to submit bids via paper.

Questions and Answers for this project are available from the Authority's website, specifically at: <a href="http://www.thruway.ny.gov/netdata/contractors/documents/d214978\_tas24-20b\_questions-and-answers-05-22-2024.pdf">http://www.thruway.ny.gov/netdata/contractors/documents/d214978\_tas24-20b\_questions-and-answers-05-22-2024.pdf</a>. This document may be updated periodically without formal issuance of an Amendment. Prospective bidders are advised to revisit this link weekly and before proposals are due, for any possible additional questions and answers information.

Additional Supplemental Information for this project is now available from the Authority's website, specifically at: <a href="http://www.thruway.ny.gov/netdata/contractors/documents/d214978\_tas24-20b\_supplemental-information-05-22-2024.zip">http://www.thruway.ny.gov/netdata/contractors/documents/d214978\_tas24-20b\_supplemental-information-05-22-2024.zip</a>

The revised quantity workup to reflect the change as mentioned below is now available and is being provided as <u>additional</u> supplemental information. Prospective bidders are advised to revisit the website weekly and before proposals are due, for any possible additional supplemental information.

#### **PROPOSAL**

1. **CHANGE** the estimated quantity for the following Item:

Contract Proposal Page	<u>Item No.</u>	<u>Description</u>	<u>Unit</u>	Initial Estimated Quantity	Revised Estimated Quantity
174	556.0203	Galvanized Bar Reinforcement for Structures	LB	54,500	100,000

The "paper" Bidder shall <u>CROSS OUT</u> the estimated quantity shown for these items in the Contract Proposal, <u>WRITE IN</u> the revised estimated quantity, and submit its bid based on the noted changes. If the Bidder fails to make these changes, the Authority will do so and adjust the BID AMOUNT for the items and TOTAL BID, accordingly.


### **PLANS**

- **2. <u>DELETE</u>** Drawing Number ST-51, Sheet 110 of 120, and <u>SUBSTITUTE</u> with the attached Drawing Number ST-51, Sheet 110-A3. Note 5 was revised to clarify payment of the reinforcement.
- **3. <u>DELETE</u>** Drawing Numbers ST-60 and ST-61, Sheets 119 and 120 of 120, and **<u>SUBSTITUTE</u>** with the attached Drawing Numbers ST-60 and ST-61, Sheets 119-A3 and 120-A3, respectively. The Bar Lists were revised to include the appropriate item number for payment.

The Bidder <u>MUST</u> complete <u>Page 197</u> of the Proposal acknowledging receipt of this amendment. If the Bidder fails to complete the "Amendment Acknowledgement" sheet, his bid could be declared informal thereby delaying award of the contract.

PLEASE BE GOVERNED ACCORDINGLY WHEN SUBMITTING BIDS.

Brent E. Howard, P.E. Chief Engineer

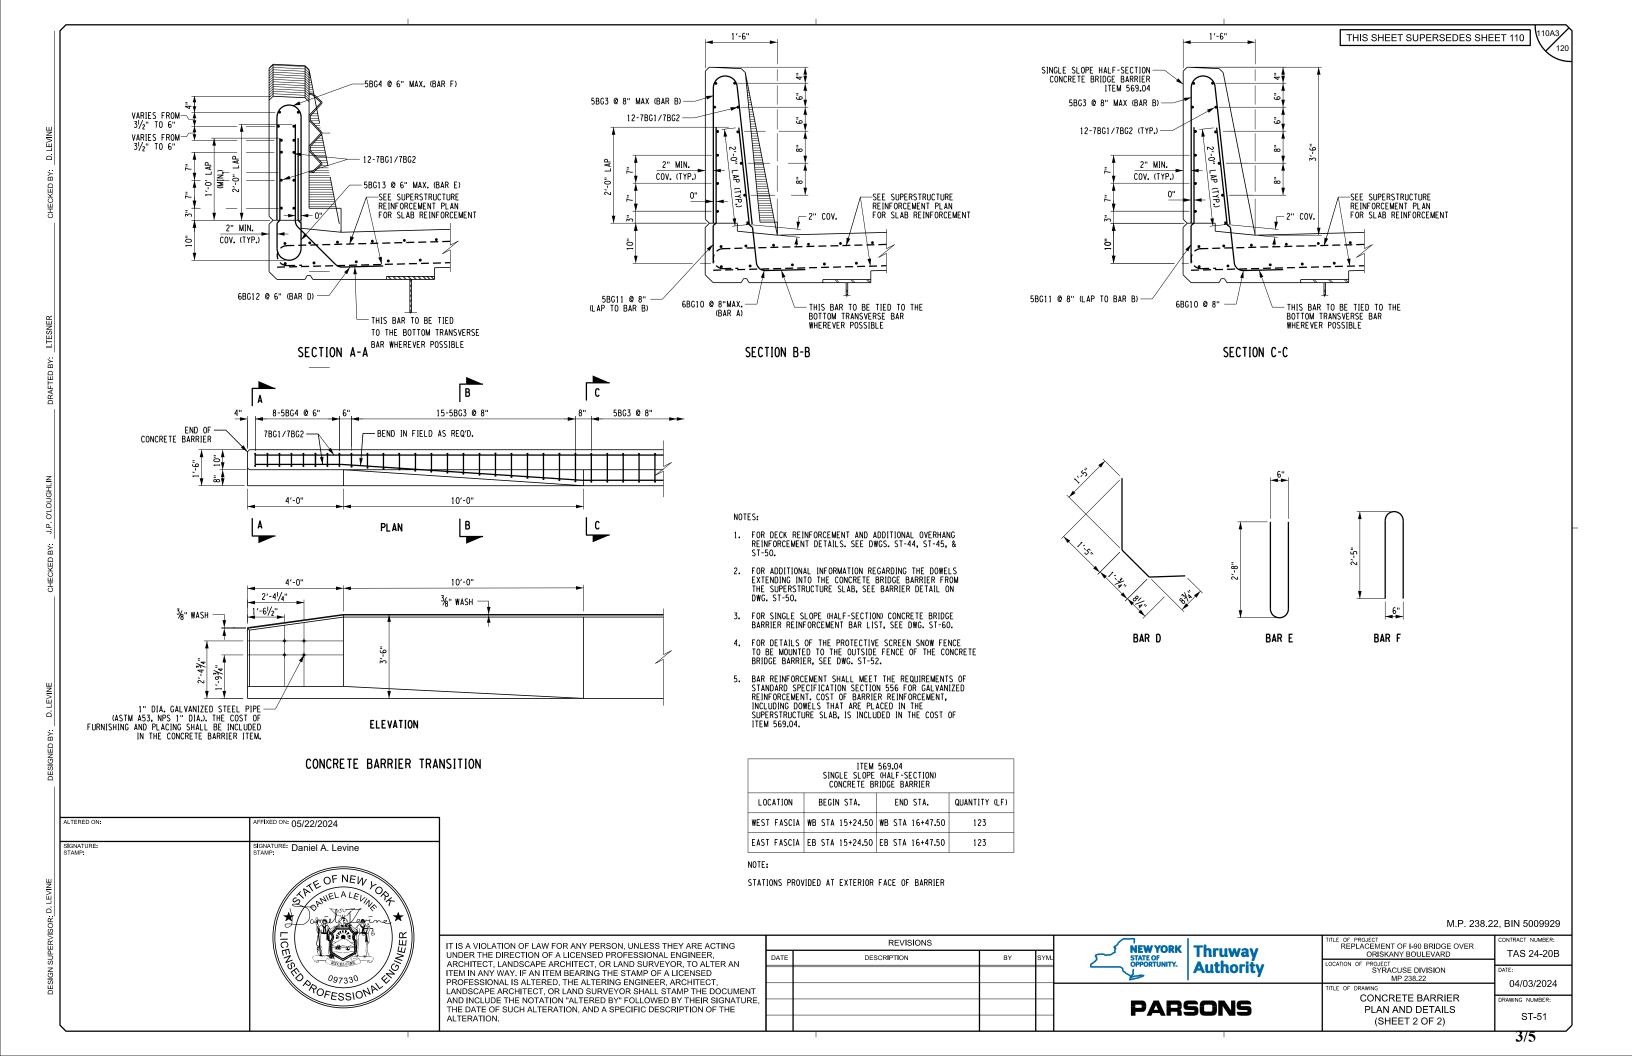

		1			1	1					1									T
MARK	QTY	SIZE	LENGTH	TYPE	WEIGHT	Α	В	С	D	E	F	G	H/H1	H2	J	K	L	0	R	REMARKS
BEGIN ABUT	MENT	1			1															
DI A CERAENIT	LOWER	CTENA (DA	  D FOR UNI	DED ITEM	FFC 0202\															
PLACEMENT 9AG1	242	9	16'-9"	2	10815	2'-8"	14'-1"					0'-0"						0'-0"		LENGTH VARIES DUE TO CROSS SLORE
	38	6	40'-0"			2-8	14 -1					0-0						40'-0"		LENGTH VARIES DUE TO CROSS SLOPE
6AG3 6AG4	38	6	23'-2"	STR STR	2284 1323													23'-2"		
5AG5	121	5	7'-4"	17	926		2'-4"	2'-8"	2'-4"									25-2		
9AG6	40	9	7'-4"	17	784		2'-4"	2'-8"	2'-4"											
5AG12	8	5	14'-4"	STR	307													14'-4"		
5AG13	16	5	7'-4"	17	314		2'-4"	2'-8"	2'-4"											
SUBTOTAL				•	16132															
PLACEMENT	- UPPER	STEM (PAI	D FOR UNI	DER ITEM	556.0203)															
6AG3	16	6	40'-0"	STR	962													40'-0"		
6AG4	16	6	23'-2"	STR	557													23'-2"		
5AG5	121	5	7'-4"	17	926		2'-4"	2'-8"	2'-4"											
5AG7	45	5	4'-3"	1	200	0'-6"	3'-3"					0'-6"								INTO APPROACH SLAB
5AG8	91	5	8'-6"	2	807	5'-6"	3'-0"													FF ABUT INTO BOTTOM OF SUP. SLAB
5AG9	91	5	27'-3"	2	2583	2'-7"	24'-8"		1											RF ABUT INTO TOP OF SUP. SLAB
5AG10	1	5	40'-0"	STR	42				1						<u> </u>			40'-0"		
5AG11	1	5	22'-11"	STR	24		a	at -::	a					-	-	-		22'-11"		
5AG13	16	5	7'-4"	17	314		2'-4"	2'-8"	2'-4"					-	-	-				
CURTOTAL	<u> </u>			<u> </u>	6101				-					-	-	-				
SUBTOTAL	\A/D\				6101				-						-	-				
TOTAL (EB &	vv Dj				44466	1	1	l	1		I	1		I	I	I	I		l	l
MARK	QTY	SIZE	LENGTH	TVDE	WEIGHT	Α	В	С	D	Е	F	G	H/H1	H2	L	Гк	1	0	R	REMARKS
IVIAIKK	QII	SIZE	LLINGIII	1111 2	WEIGITI		_ B				'		11/111	112	,	_ K			- 1	KEIVIANICS
END ABUTM	FNT		1																	
	<u> </u>																			
PLACEMENT	- LOWER	STEM (PA	D FOR UN	DER ITEM	556.0203)															
9AG2	242	9	16'-2"	2	10427	2'-8"	13'-6"					0'-0"						0'-0''		LENGTH VARIES DUE TO CROSS SLOPE
6AG3	36	6	40'-0"	STR	2163													40'-0"		
6AG4	36	6	23'-2"	STR	1253													23'-2"		
5AG5	121	5	7'-4"	17	926		2'-4"	2'-8"	2'-4"											
9AG6	40	9	7'-4"	17	784		2'-4"	2'-8"	2'-4"											
5AG12	8	5	13'-9"	STR	294													13'-9"		
5AG13	16	5	7'-4"	17	314		2'-4"	2'-8"	2'-4"											
SUBTOTAL					15553															
PLACEMENT		· · ·	1															401.011		
6AG3	16	6	40'-0" 23'-2"	STR	962										-			40'-0"		
6AG4 5AG5	16 121	5	7'-4"	STR 17	557 926		2'-4"	2'-8"	2'-4"					<del> </del>	-	-		23'-2"		
5AG5 5AG7	45	5	4'-3"	1	200	0'-6"	3'-3"	2-0	2 -4			0'-6"		<del>                                     </del>	<u> </u>					INTO APPROACH SLAB
5AG7	91	5	8'-6"	2	807	5'-6"	3'-0"		1			0.20		<del>                                     </del>	<del>                                     </del>	<del>                                     </del>				FF ABUT INTO BOTTOM OF SUP. SLAB
2700	91	5	27'-3"	2	2583	2'-7"	24'-8"							<del>                                     </del>	<del>                                     </del>	<del>                                     </del>				RF ABUT INTO TOP OF SUP. SLAB
5AG9	J +	5	40'-0"	STR	42	- /	2.0											40'-0"		
5AG9 5AG10	1				24													22'-11"		
5AG10	1	5	22'-11"	SIR			2'-4"	2'-8"	2'-4"											
	1 1 16	5 5	22'-11" 7'-4"	STR 17	314				<del></del>											
5AG10 5AG11	1																ı			
5AG10 5AG11	1																			
5AG10 5AG11 5AG13	1 16				314															
5AG10 5AG11 5AG13 SUBTOTAL	1 16				314 6101															
5AG10 5AG11 5AG13 SUBTOTAL TOTAL (EB &	1 16			17	314 6101	A	В	C	D	E	F	G	H/H1	H2	J	К	L	0	R	REMARKS
5AG10 5AG11 5AG13 SUBTOTAL TOTAL (EB &	1 16 WB)	5	7'-4"	17	314 6101 43308	A		С	D	E	F	G	H/H1	H2	J	K	L	0	R	REMARKS
5AG10 5AG11 5AG13 SUBTOTAL TOTAL (EB &	1 16 WB)	5	7'-4"	17	314 6101 43308	A		С	D	E	F	G	H/H1	H2	J	K	L	0	R	REMARKS
5AG10 5AG11 5AG13 SUBTOTAL TOTAL (EB & MARK	1 16 WB)	SIZE	7'-4"	TYPE	314 6101 43308 WEIGHT			С	D	E	F	G	Н/Н1	H2	J	К	L	0	R	REMARKS
5AG10 5AG11 5AG13 SUBTOTAL TOTAL (EB & MARK WINGWALL	1 16 WB) QTY - FOOTIN	SIZE	7'-4" LENGTH	TYPE JNDER ITE	314 6101 43308 WEIGHT			С	D	E	F	G	н/н1	H2	J	K	L		R	
5AG10 5AG11 5AG13 SUBTOTAL TOTAL (EB & MARK WINGWALL PLACEMENT 5WG1	1 16 WB) QTY - FOOTIN 16	SIZE  G POUR (I	7'-4"  LENGTH  PAID FOR U 20'-7"	TYPE  JNDER ITE STR	314 6101 43308 WEIGHT			С	D	E	F	G	H/H1	H2	J	K	L	20'-7"	R	REMARKS  LENGTH VARIES, AVERAGE LENGTH USED
5AG10 5AG11 5AG13 SUBTOTAL TOTAL (EB & MARK WINGWALL PLACEMENT 5WG1 6WG2	1 16 WB)  QTY  - FOOTIN 16 36	SIZE  G POUR (I	7'-4"  LENGTH  PAID FOR U 20'-7" 7'-0"	TYPE  JNDER ITE  STR  STR	314 6101 43308 WEIGHT EM 556.020 344 379			С	D	E	F	G	H/H1	H2	J	K	L	20'-7" 7'-0"	R	LENGTH VARIES, AVERAGE LENGTH USED
5AG10 5AG11 5AG13 SUBTOTAL TOTAL (EB & MARK WINGWALL PLACEMENT 5WG1	1 16 WB) QTY - FOOTIN 16	SIZE  G POUR (I	7'-4"  LENGTH  PAID FOR U 20'-7"	TYPE  JNDER ITE STR	314 6101 43308 WEIGHT			C	D	E	F	G	H/H1	H2	J	K	L	20'-7"	R	
5AG10 5AG11 5AG13 SUBTOTAL TOTAL (EB & MARK WINGWALL PLACEMENT 5WG1 6WG2	1 16 WB)  QTY  - FOOTIN 16 36	SIZE  G POUR (I	7'-4"  LENGTH  PAID FOR U 20'-7" 7'-0"	TYPE  JNDER ITE  STR  STR	314 6101 43308 WEIGHT EM 556.020 344 379			C	D	E	F	G	Н/Н1	H2	J	K	L	20'-7" 7'-0"	R	LENGTH VARIES, AVERAGE LENGTH USED

M.P. 238.22, BIN 5009929

IT IS A VIOLATION OF LAW FOR ANY PERSON, UNLESS THEY ARE ACTING UNDER THE DIRECTION OF A LICENSED PROFESSIONAL ENGINEER, ARCHITECT, LANDSCAPE ARCHITECT, OR LAND SURVEYOR, TO ALTER AN ITEM IN ANY WAY, IF AN ITEM BEARING THE STAMP OF A LICENSED PROFESSIONAL IS ALTERED, THE ALTERING ENGINEER, ARCHITECT, LANDSCAPE ARCHITECT, OR LAND SURVEYOR SHALL STAMP THE DOCUMENT AND INCLUDE THE NOTATION "ALTERED BY" FOLLOWED BY THEIR SIGNATURE, THE DATE OF SUCH ALTERATION, AND A SPECIFIC DESCRIPTION OF THE ALTERATION.

ALTERED ON:

AFFIXED ON: 05/22/2024

SIGNATURE: Daniel A. Levine

TATE OF NEW ,

REVISIONS									
DATE	DESCRIPTION	BY	SYM.						

**PARSONS** 

,	TITLE OF PROJECT REPLACEMENT OF I-90 BRIDGE OVER ORISKANY BOULEVARD	CONTRACT NUMBER: TAS 24-20B		
V	LOCATION OF PROJECT SYRACUSE DIVISION	DATE:		
<u> </u>	MP 238.22	04/03/2024		
	TITLE OF DRAWING	04/03/2024		
		DRAWING NUMBER:		

BAR LIST (SHEET 1 OF 2)

ST-60

PLACEMENT - STEM POUR (PAID FOR UNDER ITEM 556.0203) 1'-2" 10'-8" 0'-0" LENGTH VARIES. AVERAGE LENGTH USED 5WG4 5 11'-10" 17 248 1'-5" 10'-8" 0'-0" LENGTH VARIES, AVERAGE LENGTH USED 12'-1" 6 16'-7" 17 100 1'-5" 15'-2" 0'-0" 5WG7 16'-4" 17 86 1'-2" 15'-2" 0'-0" N12 18'-10" 1'-8" 0'-0" 5WG8 22'-11" N12 146 21'-4" 0'-9" 0'-0" 0'-6" 5WG9 23'-2" 0'-6" 5WG10 5 13'-6" N12 155 9'-5" 1'-8" 0'-0" 1'-2" 1'-3" LENGTH VARIES, AVERAGE LENGTH USED 5WG11 11 5 13'-10" N12 159 12'-0" 0'-9" 0'-0" 0'-6" 0'-6" LENGTH VARIES, AVERAGE LENGTH USED 5 6'-9" 1'-6" 2'-8" 0'-3" 5WG12 16 N10 113 0'-10" 0'-10" 1 5 23'-11" 12 25 0'-0" 0'-0" 2'-10" 21'-1" 0'-0" 0'-0" 5WG13 0'-0" PERIMETER SUBTOTAL 1868 TOTAL (BAR/EAL & BAL/EAR) 11044 QTY SIZE LENGTH TYPE WEIGHT A B C D E F G H/H1 H2 J K L O R SUPERSTRUCTURE SLAB PLACEMENT - SUPERSTRUCTURE SLAB (PAID FOR UNDER ITEM 557.1119) 122 4 40'-0" 1 3260 0'-6" 39'-2" LAPPED TO 4SG2 4 23'-9" 1 1937 0'-6" 22'-11" 4SG2 0'-0" 0'-4" LAPPED TO 4SG1 4SG3 4 40'-0" STR 3260 40'-0" LAPPED TO 4SG4 4SG4 122 4 22'-1" STR 1802 22'-1" LAPPED TO 4SG3 528 4 40'-0" STR 14109 4SG5 40'-0" 4SG6 7'-2" STR 7'-2" 843 5SG7 5 40'-0" STR 1502 40'-0" 36 STR 121 5SG8 5 9'-8" 9'-8" 1 6SG9 244 6 6'-2" 2261 0'-8" 5'-6" 0'-0" 0'-6" 4 1'-8" 2'-0" 1'-5" 3'-1" 12 1'-5" CORNER DETAIL BAR 4SG14 8 3'-8" 20 SUBTOTAL 29115 PLACEMENT - BARRIER REINFORCEMENT EMBEDDED IN DECK (PAID FOR UNDER ITEM 569.04) 174 6 4'-1" A 1068 VARIES IN BARRIER TRANSITION 6BG10 5BG11 174 3'-0" STR 3'-0" 6 4'-2" D 101 16 6BG12 5BG13 16 5 6'-2" E 103 SUBTOTAL (EACH BARRIER) 1817 SUBTOTAL (EACH SLAB) 30932 SUPERSTRUCTURE SLAB TOTAL (2 SLABS) 61864 QTY SIZE LENGTH TYPE WEIGHT A B C D E F G H/H1 H2 0 REMARKS MARK PLACEMENT - APPROACH SLAB (PAID FOR UNDER ITEM 557.1019) 5HG1 178 5 23'-0" STR 4271 23'-0" 48 5HG2 5 40'-0" STR 2003 40'-0" 5 20'-11" STR 5HG3 48 1049 20'-11" SUBTOTAL (EACH SLAB) 7323 APPROACH SLAB TOTAL (4 SLABS) PLACEMENT - SLEEPER SLAB (PAID FOR UNDER ITEM 557.1019) 5 40'-0" STR 668 5HG3 16 5 20'-11" STR 350 20'-11" 5HG4 120 5 5'-6" STR 689 5'-6" 5HG5 4'-6" 17 282 60 1'-6" 1'-6" 1'-6" SUBTOTAL (EACH SLAB) SLEEPER SLAB TOTAL (4 SLABS) 7956 E F G MARK QTY SIZE LENGTH TYPE WEIGHT A B C D H/H1 H2 REMARKS K L O J ALTERED ON: FFIXED ON: 05/22/2024 PLACEMENT - SINGLE SLOPE CONCRETE BARRIER (PAID FOR UNDER ITEM 569.04) 36 7 40'-0" STR 2944 7BG1 40'-0" SIGNATURE: Daniel A. Levine 12 7 9'-8" STR 238 174 5 6'-7" 5 5'-8" SATE OF NEW L 5BG3 VARIES IN BARRIER TRANSITION B 1188 F 5BG4 16 94 OANIEL A LEVING SUBTOTAL (EACH BARRIER) 4464 BARRIER TOTAL (EB & WB) 8928 M.P. 238.22. BIN 5009929 E OF PROJECT REPLACEMENT OF I-90 BRIDGE OVER ORISKANY BOULEVARD REVISIONS IT IS A VIOLATION OF LAW FOR ANY PERSON, UNLESS THEY ARE ACTING UNDER THE DIRECTION OF A LICENSED PROFESSIONAL ENGINEER, **NEW YORK** Thruway TAS 24-20B BY STATE OF OPPORTUNITY. LOCATION OF PROJECT
SYRACUSE DIVISION
MP 238.22 ARCHITECT, LANDSCAPE ARCHITECT, OR LAND SURVEYOR, TO ALTER AN Authority ITEM IN ANY WAY IF AN ITEM BEARING THE STAMP OF A LICENSED. PROFESSIONAL IS ALTERED, THE ALTERING ENGINEER, ARCHITECT 04/03/2024 POFESSION TITLE OF DRAWING LANDSCAPE ARCHITECT, OR LAND SURVEYOR SHALL STAMP THE DOCUMENT AND INCLUDE THE NOTATION "ALTERED BY" FOLLOWED BY THEIR SIGNATURE,

THE DATE OF SUCH ALTERATION, AND A SPECIFIC DESCRIPTION OF THE ALTERATION.

5

ST-61

BAR LIST (SHEET 2 OF 2)

**PARSONS** 

THIS SHEET SUPERSEDES SHEET 120