# NEW YORK STATE THRUWAY AUTHORITY DEPARTMENT OF ENGINEERING

ALBANY, NY NOVEMBER 14, 2025

#### AMENDMENT NO. 1 TO

CONTRACT TAB 25-13
D215028
PAVEMENT REHABILITATION, SAFETY IMPROVEMENTS
AND MISCELLANEOUS WORK ON I-90
FROM MILEPOST 419.4 TO 425.9
IN THE BUFFALO DIVISION
OF THE NEW YORK STATE THRUWAY
IN ERIE COUNTY

### IN THE LETTING OF NOVEMBER 19, 2025

NOTE: This amendment shall be attached to and become a part of the Proposal for Contract TAB 25-13.

#### **NOTICE**

For Electronic Bidders, the Project's amended EBSX file will automatically account for any necessary item changes (deletions, changes in quantities, or additions) that this Amendment may describe as being required regarding the project's estimated cost. Instructions to make physical changes to the Project Proposal's bid sheets are intended for "paper" Bidders who choose to submit bids via paper.

Questions and Answers for this project are available from the Authority's website, specifically at: <a href="http://www.thruway.ny.gov/netdata/contractors/documents/d215028\_tab25-13\_questions-and-answers-11-14-2025.pdf">http://www.thruway.ny.gov/netdata/contractors/documents/d215028\_tab25-13\_questions-and-answers-11-14-2025.pdf</a>. This document may be updated periodically without formal issuance of an Amendment. Prospective bidders are advised to revisit this link weekly and before proposals are due, for any possible additional questions and answers information.

#### **PROPOSAL**

- 1. On pages 1 and 175, and in all other locations in the Contract Proposal, <u>CHANGE</u> the COMPLETION DATE to <u>November 19, 2027</u>.
- **2. DELETE** the following Item:

Contract Proposal Page	<u>Item No.</u>	<u>Description</u>	<u>Unit</u>	Estimated Quantity
192	654.5020	Expandable Impact Attenuator, TL-2, <= 2FT Obstruction Width	EA	5

The "paper" Bidder shall <u>CROSS OUT</u> and not enter a bid for these items in the Contract Proposal. If the Bidder fails to make these changes, the Authority will do so and adjust the TOTAL BID, accordingly.

**<u>DELETE</u>** all other references to the above item in the Contract Plans and Contract Proposal.

3.	CHANGE	the est	imated	quantity	for the	e following	Items:

Contract				<u>Initial</u>	Revised
<u>Proposal</u>	Item No.	<u>Description</u>	<u>Unit</u>	<b>Estimated</b>	<b>Estimated</b>
Page				Quantity	Quantity
177	203.03	Embankment in Place	CY	1,071	1,178
178	404.0002	Pavement Density Quality Adjustment to Asphalt Items	QU	20,800	3,100
189	637.12 25	Engineer's Field Office - Type 2	MNTH	24	26

The "paper" Bidder shall <u>CROSS OUT</u> the estimated quantity shown for these items in the Contract Proposal, <u>WRITE IN</u> the revised estimated quantity, and submit its bid based on the noted changes. If the Bidder fails to make these changes, the Authority will do so and adjust the BID AMOUNT for the items and TOTAL BID, accordingly.

#### 4. **ADD** the following Items:

Contract Proposal Page	Item No.	<u>Description</u>	<u>Unit</u>	Estimated Quantity
194A-A1	555.0021	Concrete for Structures, Performance	CY	29
194A-A1	555.9902	Performance Concrete Quality Adjustment – Concrete for Structures	QU	1
194A-A1	559.02	Protective Sealing of New Structural Concrete	SF	590
194A-A1	654.5030	Expandable Impact Attenuator, TL-3 <=2Ft Obstruction	EA	5

The "paper" Bidder must **RETURN THE ATTACHED PAGE 194A-A1** with its bid for this Contract.

- 5. <u>REPLACE</u> page 81 with the attached page <u>81-A1</u>. The required PG Binder has been corrected from PG 64E-22 to PG 64V-22.
- **6.** <u>ADD</u> the attached page <u>85A-A1</u>. The required Special Note for Material Transfer Vehicle (MTV) is now available.

#### **PLANS**

- 7. <u>DELETE</u> Drawing Number TYP-11, Sheet 15 of 371, and <u>SUBSTITUTE</u> with the attached Drawing Number TYP-11, Sheet 15-A1 of 371. Notes were added to clarify the use of Items 404.1252 and 404.1272.
- 8. <u>DELETE</u> Drawing Number TYP-13, Sheet 17 of 371, and <u>SUBSTITUTE</u> with the attached Drawing Number TYP-13, Sheet 17-A1 of 371. Notes were added to clarify the use of Items 404.1252 and 404.1272.

- 9. <u>DELETE</u> Drawing Number TYP-14, Sheet 18 of 371, and <u>SUBSTITUTE</u> with the attached Drawing Number TYP-14, Sheet 18-A1 of 371. Notes were added to clarify the use of Items 404.1252 and 404.1272.
- **10**. **<u>DELETE</u>** Drawing Number TYP-15, Sheet 19 of 371, and <u>SUBSTITUTE</u> with the attached Drawing Number TYP-15, Sheet 19-A1 of 371. Notes were added to clarify the use of Items 404.1252 and 404.1272.
- 11. <u>DELETE</u> Drawing Number MST-4, Sheet 134 of 371, and <u>SUBSTITUTE</u> with the attached Drawing Number MST-4, Sheet 134-A1 of 371. Stations 197+20 thru 199+60 were removed from the "Table of Proposed Concrete Median Barrier Elevation Difference".
- **12. <u>DELETE</u>** Drawing Number MST-9, Sheet 139 of 371, and **<u>SUBSTITUTE</u>** with the attached Drawing Number MST-9, Sheet 139-A1 of 371. Reference to Item 654.5020 was changed to Item 654.5030, instead.
- **13. <u>DELETE</u>** Drawing Number MST-10, Sheet 140 of 371, and **<u>SUBSTITUTE</u>** with the attached Drawing Number MST-10, Sheet 140-A1 of 371. Reference to Item 654.5020 was changed to Item 654.5030, instead.
- **14. <u>DELETE</u>** Drawing Number MST-11, Sheet 141 of 371, and **<u>SUBSTITUTE</u>** with the attached Drawing Number MST-11, Sheet 141-A1 of 371. Reference to Item 654.5020 was changed to Item 654.5030, instead.
- **15. <u>DELETE</u>** Drawing Number MST-12, Sheet 142 of 371, and **<u>SUBSTITUTE</u>** with the attached Drawing Number MST-12, Sheet 142-A1 of 371. Reference to Item 654.5020 was changed to Item 654.5030, instead.
- **16. <u>DELETE</u>** Drawing Number MSD-1, Sheet 143 of 371, and **<u>SUBSTITUTE</u>** with the attached Drawing Number MSD-1, Sheet 143-A1 of 371. Reference to Barrier Item 606.3041 was removed from the "Inlet Protection" Detail.
- **17. <u>DELETE</u>** Drawing Number MSD-2, Sheet 144 of 371, and **<u>SUBSTITUTE</u>** with the attached Drawing Number MSD-2, Sheet 144-A1 of 371. The "Precast Pier Protection Barrier Detail" has been modified to show the dimensions and pay item for the required soil backup.
- **DELETE** Drawing Number MSD-3, Sheet 145 of 371, and **SUBSTITUTE** with the attached Drawing Number MSD-3, Sheet 145-A1 of 371. In the "Overpass Median Barrier Transition Detail" reference to Item 606.3042 was changed to Item 606.3041, instead. In addition, previous reference to Item 555.0105 has been removed and Item 555.0021 and Item 559.02 were added to the "Median Barrier Sign Structures Detail".
- **19.** <u>DELETE</u> Drawing Number SPK-1, Sheet 153 of 371, and <u>SUBSTITUTE</u> with the attached Drawing Number SPK-1, Sheet 153-A1 of 371. Item 606.3042 was changed to Item 606.3041.
- **20. <u>DELETE</u>** Drawing Number SPK-2, Sheet 154 of 371, and **<u>SUBSTITUTE</u>** with the attached Drawing Number SPK-2, Sheet 154-A1 of 371. Item 606.3042 was changed to Item 606.3041 and a callout (to Item 606.3062) was updated to (also) reference existing Note 4.

- **21. <u>DELETE</u>** Drawing Number GNP-33, Sheet 189 of 371, and **<u>SUBSTITUTE</u>** with the attached Drawing Number GNP-33, Sheet 189-A1 of 371. A Note was added to reference Drawing Number MSD-2 regarding the soil backup requirement at the pier protection.
- **22. <u>DELETE</u>** Drawing Number DND-1, Sheet 329 of 371, and **<u>SUBSTITUTE</u>** with the attached Drawing Number DND-1, Sheet 329-A1 of 371. The call out to Item 606.3042 in the "Proposed Drainage System" Detail was corrected to Item 606.3041, instead.
- **23. <u>DELETE</u>** Drawing Number DNP-24, Sheet 358 of 371, and **<u>SUBSTITUTE</u>** with the attached Drawing Number DNP-24, Sheet 358-A1 of 371. A new Note 5 now referring to Drawing Number TYP-18 and the "Typical Section S" Detail was added regarding the installation of the 24" R.C.C.P.

The Bidder <u>MUST</u> complete Page <u>208</u> of the Proposal acknowledging receipt of this amendment. If the Bidder fails to complete the "Amendment Acknowledgement" sheet, his bid could be declared informal thereby delaying award of the contract.

PLEASE BE GOVERNED ACCORDINGLY WHEN SUBMITTING BIDS.

Brent E. Howard, P.E. Chief Engineer

### SPECIAL NOTE

#### PG BINDER AND MIX DESIGN LEVEL

Requirements of this note apply to all Section 404 Asphalt Pavement items in this contract, except for shim, permeable base, temporary pavements, and miscellaneous, which may use non-modified PG binders such as PG 64S-22 and PG 64H-22.

#### **PG BINDER**

Use polymer or Terminal Blend Crumb Rubber modified **PG 64V-22** (Very High) meeting the requirements of AASHTO M 332, *Standard Specification for Performance Graded Asphalt Binder using Multiple Stress Creep Recovery (MSCR)*, for the production of asphalt mixtures for this project. In addition, the binder grade must also meet the **elastomeric** properties as indicated by one of the following equations for %R<sub>3.2</sub>:

- 1. For  $J_{nr3,2} \ge 0.1$ ,  $R_{3,2} > 29.371 * J_{nr3,2}^{-0.2633}$
- 2. For  $J_{nr3,2} < 0.1$ ,  $R_{3,2} > 55$

#### Where:

R<sub>3.2</sub> is % recovery at 3.2 kPa

Jnr3.2 is the average non-recoverable creep compliance at 3.2 kPa

When terminal blend CRM PG binder is used, the following shall apply:

- Crumb rubber particles shall be finer than #30 sieve size.
- The CRM PG binder shall be storage-stable and homogeneous.
- The Dynamic Shear Rheometer (DSR) shall be set at 2-mm gap.
- The CRM PG binder shall be 99% free of particles retained on the 600 µm sieve as tested in accordance with Section 5.4 of M 332.

Use of polyphosphoric acid (PPA) to modify the PG binder properties is prohibited for mixtures under this contract. This prohibition also applies to the use of PPA as a cross-linking agent for polymer modification.

#### **MIX DESIGN**

The mixture designs must be developed in accordance with the criteria specified in the asphalt pavement items that are appropriate for the Mixture Design Level of **75 Gyrations**.

<u>Note:</u> The PG binder for this project will be modified with polymer or CRM additives to meet the requirements stated above. Handling of the asphalt mixtures shall be discussed at pre-construction and pre-paving meetings.

#### 85A-A1

#### MATERIAL TRANSFER VEHICLE (MTV)

The Contractor is required to use a self-propelled Material Transfer Vehicle (MTV) to transfer asphalt pavement from the hauling units to the paving equipment when placing asphalt for mainline paving.

The MTV system shall be specifically designed and constructed for the purpose of unloading delivery vehicles, storing, and remixing asphalt materials, and transferring materials to the paver. No substitutes such as pick-up machines will be allowed. The MTV shall have a storage bin and a conveyor system to deliver the asphalt mixture to the paving equipment. In addition to the MTV, the asphalt paver shall be equipped with a paver hopper insert. The paver hopper insert, or MTV shall have a remixing auger system capable of continuously blending the asphalt for the purposes of eliminating segregation in the finished mat. The combined minimum storage capacity of the MTV and paver hopper insert shall be 30 tons. The Engineer shall approve all equipment prior to commencement of paving.

Use of the MTV system for paving on bridge structures is not required. The MTV system shall not exceed maximum legal loadings when crossing structures.

An MTV will not be required when placing Truing and Leveling pavement courses.

Operation of the MTV shall be non-contact with the paver and controlled by an auto tracking mechanism that synchronizes the machine's forward speed with the paver. The MTV shall provide continuous flow of asphalt to the paver during daily paving operations. If a discontinuous flow of asphalt occurs or if excessive segregation is evident in the finished surface, paving shall be halted and the Contractor must take necessary corrective actions prior to the resumption of paving.

General operation and cleaning restrictions of the MTV shall meet the requirements of Section 404 for Pavers.

The cost for the MTV and paver hopper insert shall be included under the appropriate asphalt pavement items.




11/14/2025 2:09:10 PM


AASHTOWare Project™ Version 5.01.05 Revision 043


# **Proposal Schedule of Items**


Proposal ID:	D215028		Project(s):	B53052	
Contractor:					-
SECTION:		Not Assigned to a Section			
Alt Set ID:		Alt Mbr ID:			

Proposal Line	Item ID	Approximate	Unit Price	Bid Amount	
Number	Description	Quantity and Units	Dollars Cents	Dollars Cents	
0400	555.0021 CONCRETE FOR STRUCTURES, PERFORMANCE	29.000 CY			
0402	555.9902 PERFORMANCE CONCRETE QUALITY ADJUSTMENT - CONCRETE FOR STRUCTURES	1.000 QU	7.50000	7.50	
0404	559.02 PROTECTIVE SEALING OF NEW STRUCTURAL CONCRETE	590.000 SF		<del>.</del>	
0406	654.5030  EXPENDABLE IMPACT ATTENUATOR, TL3, LESS THAN OR EQUAL TO 2 FOOT OBSTRUCTION WIDTH	5.000 EACH			
	Section:		Total:	<u> </u>	

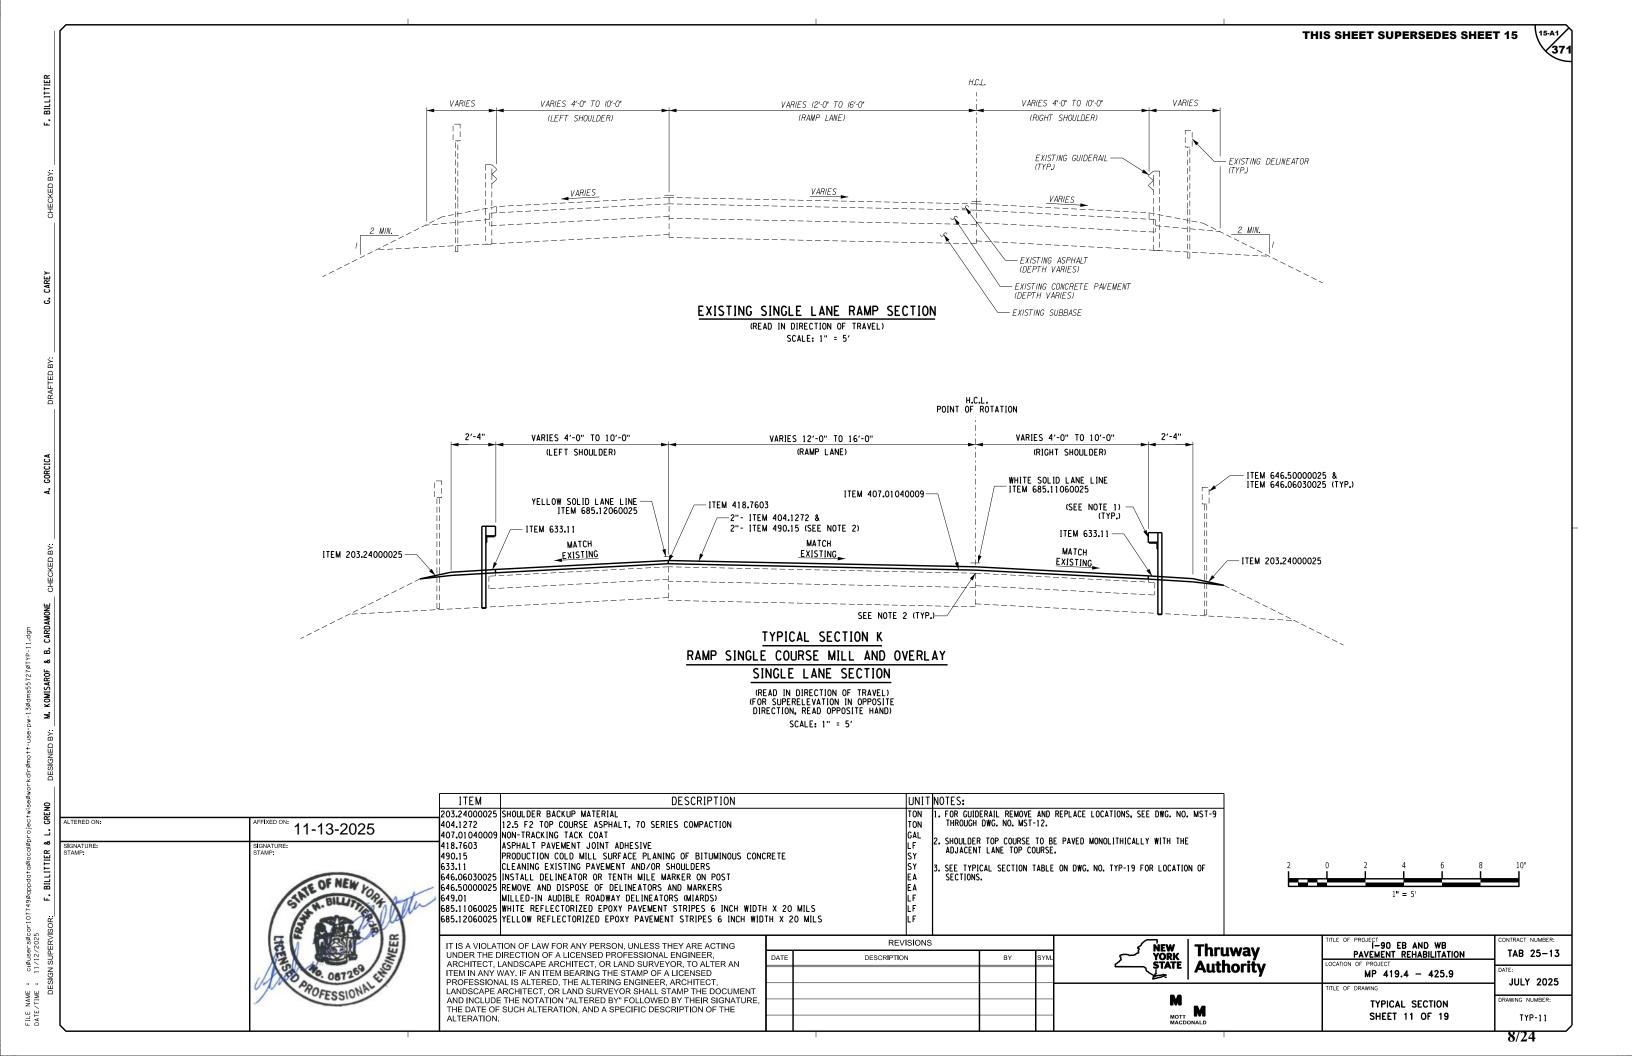

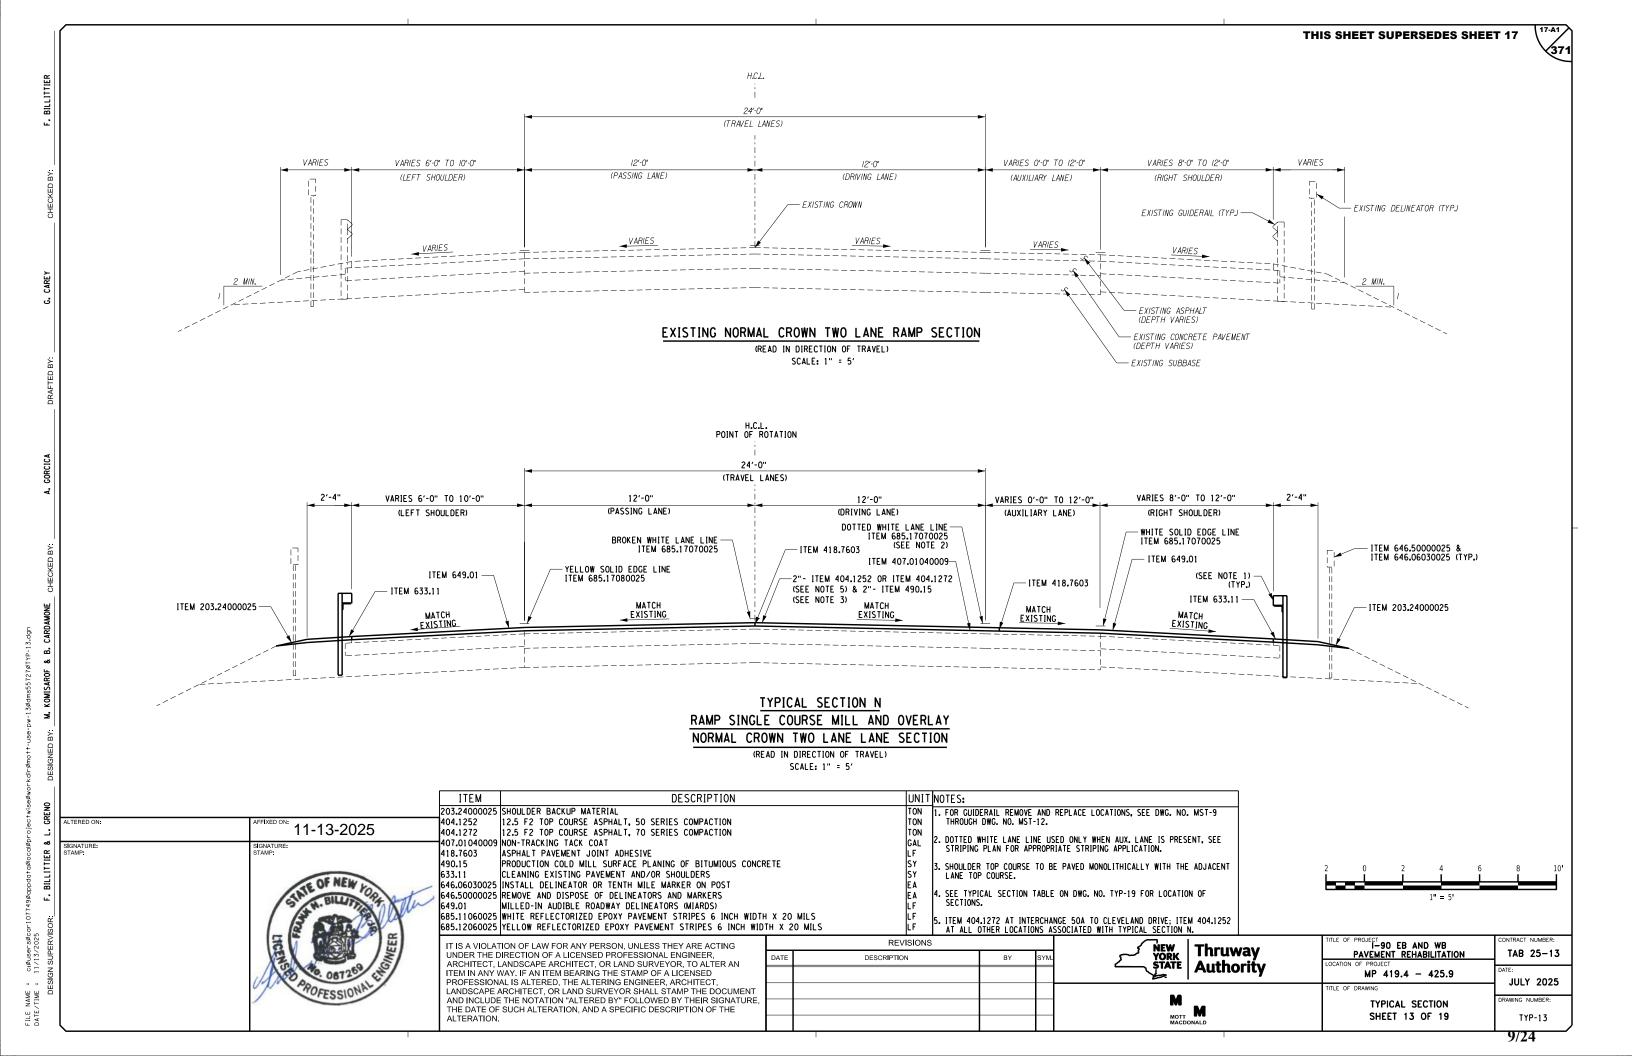

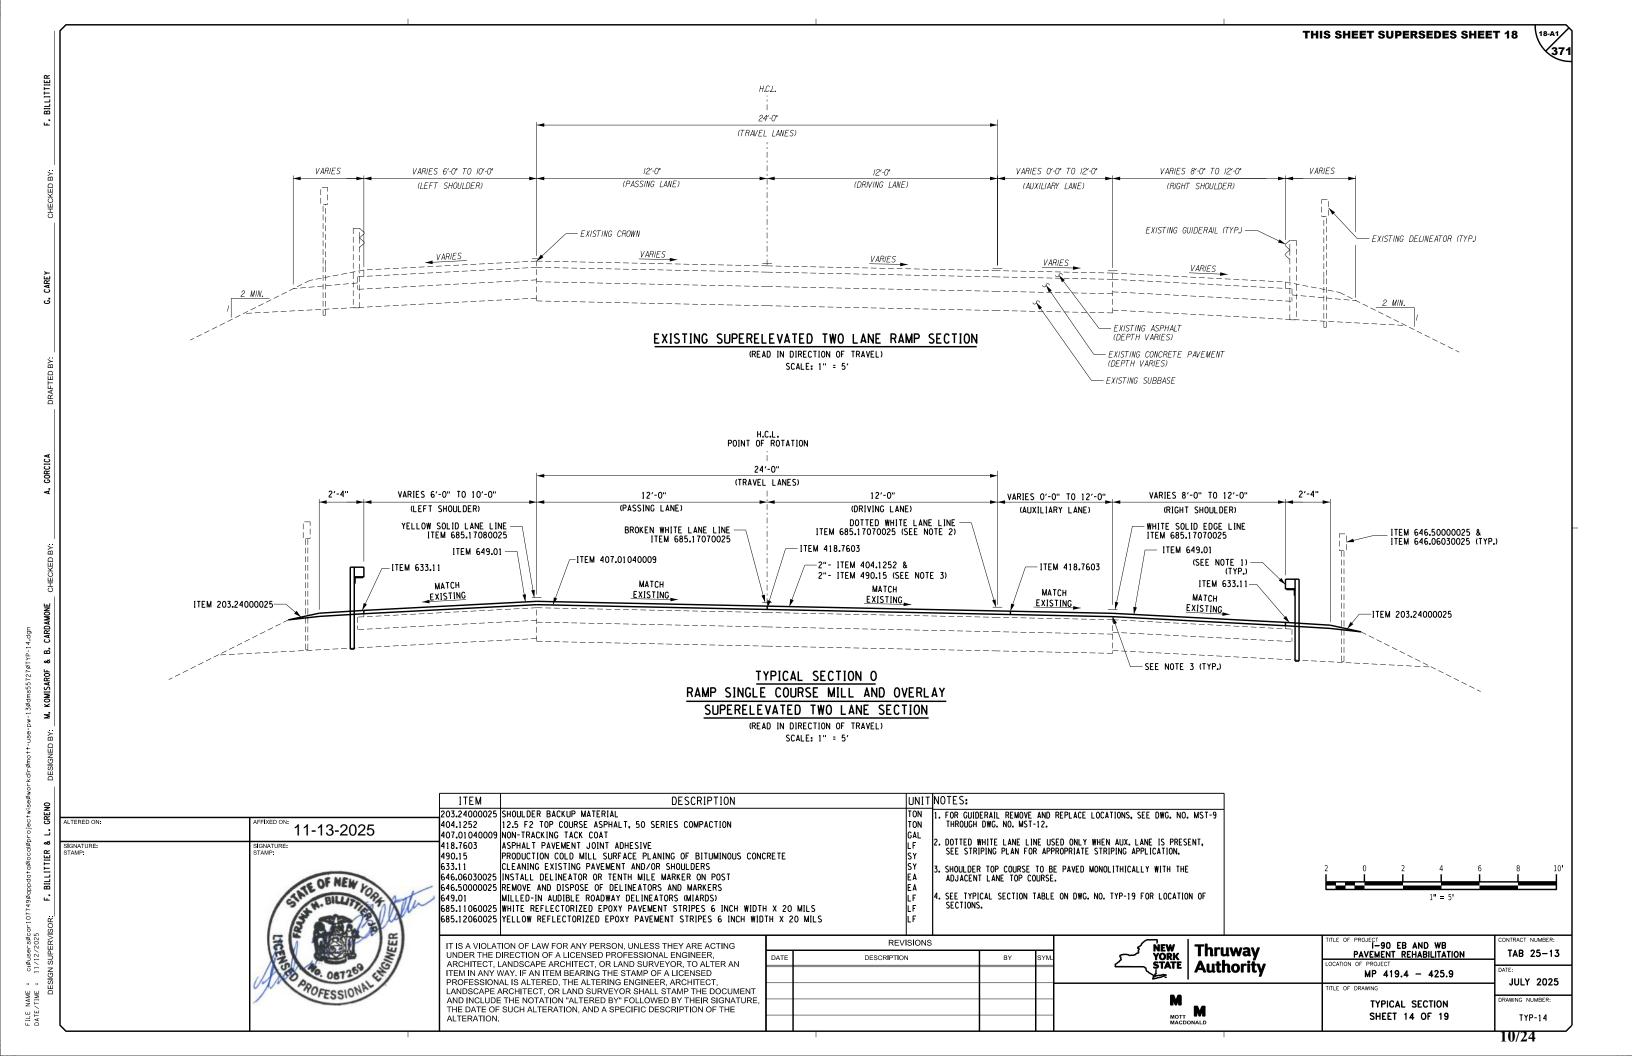

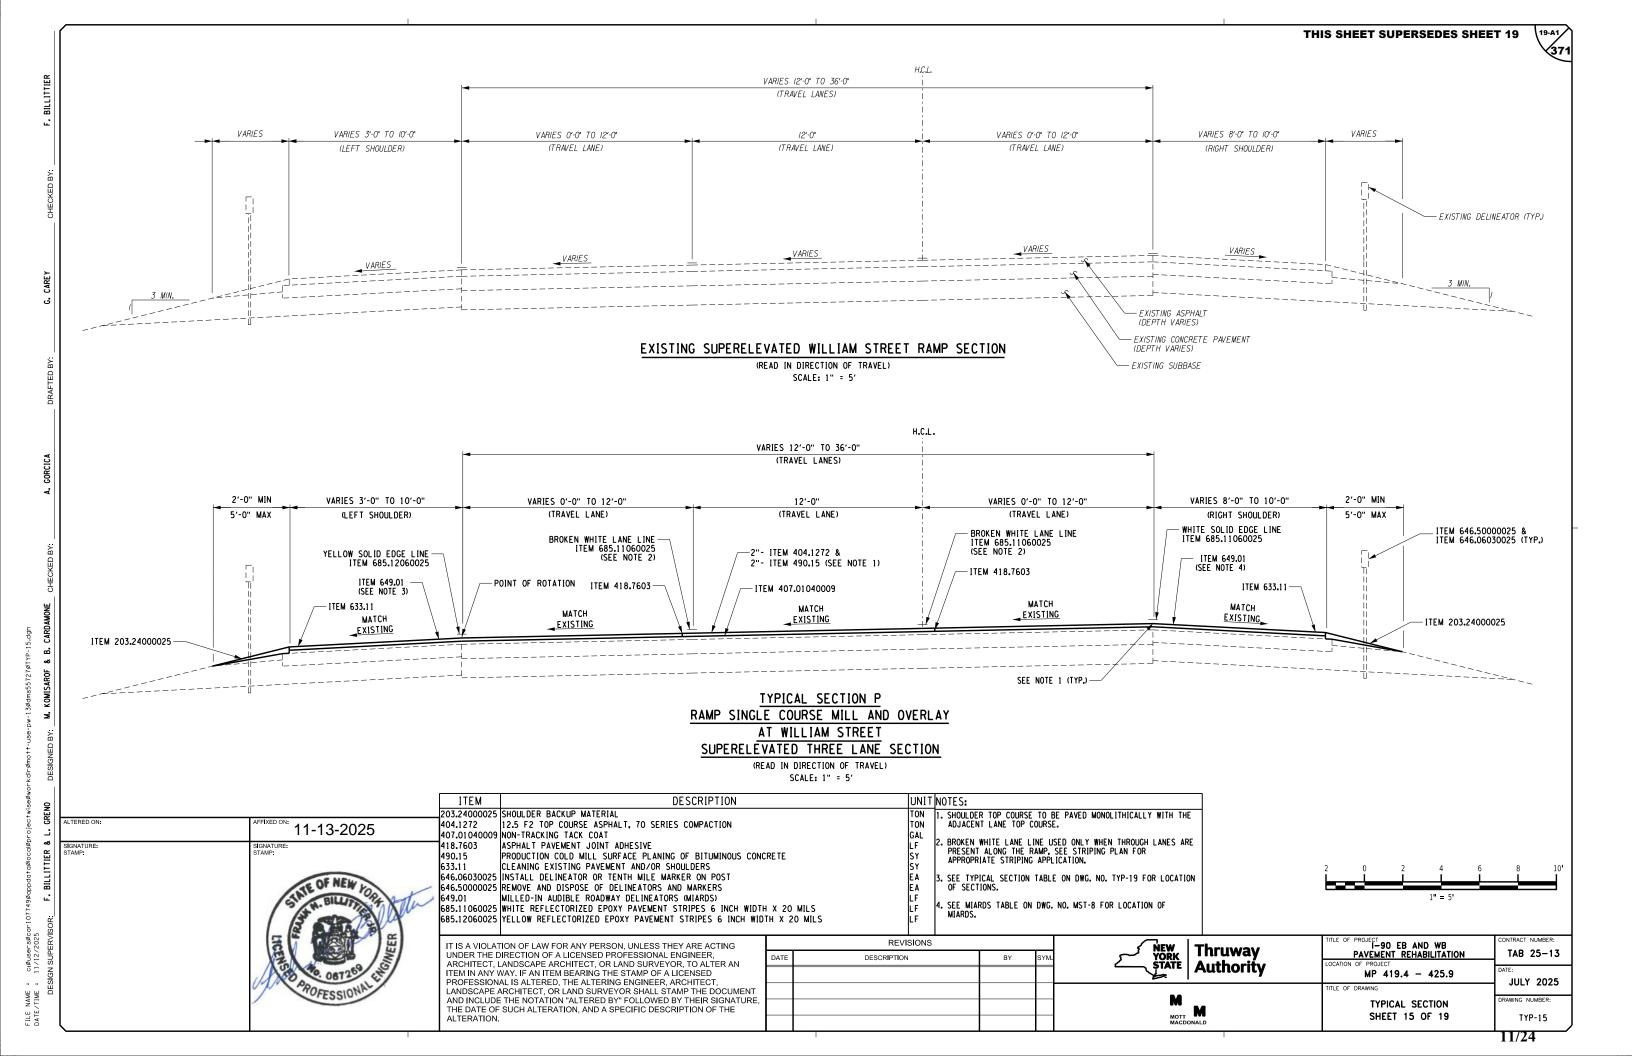

F ILE DATE

GRENO		
نـ	ALTERED ON:	AFFIXED ON: 11-13-2025
E = 11/13/2025 DESIGN SUPERVISOR: F. BILLITTIER &	SIGNATURE: STAMP:	SIGNATURE: STAMP:
DATE/TIME = 11 DESIGN		AROFESSIONAL

TABLE OF PROPOSED SNOWPLOW MARKERS

INSTALL SNOWPLOW
MARKER, SINGLE

UNIT (EA)

1

INTERCHANGE 50A

INTERCHANGE 50

1

1

1

1

51

MAINL INE

SIDE

RT

LΤ

LT

LT

RT

RT

LT

RT

LΤ

LT

LT

LT

RT

RT

LT

RT

RT

RT

LT

LT

LT

RT

LT

(STATION)

STA. LE 1+85

STA. LF 1+85

STA. LF 3+05

STA. LF 8+80

STA. CW 4+10

STA. CW 6+45

STA. CW 8+05

STA. MA 8+50

STA. MA 9+70

STA. MA 19+00

STA. MA 23+55

STA. MA 27+55

STA. MB 3+50

STA. MB 4+80

STA. MB 5+80

STA. MB 16+85

STA. MB 17+50

STA. MB 29+20

STA. MB 31+40

STA. MC 20+50

STA. MC 25+00

STA. MC 34+45

STA. MC 41+50

STA. MC 44+05

STA. MC 44+80

STA. MD 7+15

STA. MD 9+75

STA. MD 18+60

STA. MD 20+40

TOTAL:

ITEM 646.0801--25 | ITEM 646.0802--25

INSTALL SNOWPLOW

MARKER, DOUBLE UNIT (EA)

1

1

51

	PR0	POSED FULL DEPTH	H REPAIR TA	BLE	
FROM STA.	TO STA.	LANE TYPE	DIRECTION	WIDTH (FT)	AREA (SY)
		MAINLINE	-		
158+88	158+96	DRIVING	EB	12	10.7
284+97	285+05	CENTER	EB	12	10.7
304+88	304+96	DRIVING	EB	12	10.7
308+89	308+97	DRIVING	EB	12	10.7
333+28	333+36	PASSING	EB	13	11.6
358+47	358+55	DRIVING	EB	12	10.7
358+57	358+65	CENTER	EB	12	10.7
395+01	395+09	PASSING	EB	13	11.6
401+87	401+95	PASSING	EB	13	11.6
162+61	162+69	CENTER	WB	12	10.7
163+24	163+32	DRIVING	WB	12	10.7
173+11	173+19	CENTER	WB	12	10.7
183+73	183+81	CENTER	WB	12	10.7
188+58	188+66	CENTER	WB	12	10.7
200+04	200+12	CENTER	WB	12	10.7
225+17	225+25	CENTER	WB	12	10.7
229+19	229+27	CENTER	WB	12	10.7
395+93	396+01	DRIVING	WB	12	10.7
396+40	396+48	CENTER	WB	12	10.7
410+77	410+85	CENTER	WB	12	10.7
O ACCOUNT FOI	R UNIDENTIFIED FULL DEPTH REI	AND NEW FULL DEPTH REPAPAIR ITEM QUANTITIES FOR	AIR AREAS AOBE.	A 100% FACTOR DSES.	WAS APPLIED
		INTERCHANGE	50A		
CE 12+42	CE 14+17	PASSING/DRIVING	-	25	486.1
		INTERCHANGE	50		
MC 21+50	MC 22+41	PASSING	-	12	121.3
MC 41+05	MC 43+37	PASSING	-	12	309.3

INDUCTANCE LOOPS TABLE								
ASSET ID	MILEPOST	DIRECTION	NO. OF LOOPS	206.03	680.52080325	680,58400025	680.71	
				LF	LF	EA	LF	
TDS-98	420.5	₩B	4	67.2	67.2	4	54	
TDS-99	420.5	EB	4	68.8	68.8	4	40	
TDS-100	421.1	EB	8	147.2	147.2	8	62	
TDS-101	421.1	₩B	8	108.0	108	8	30	
TDS-102	422.4	EB	6	94.8	94.8	6	45	
TDS-103	422.4	₩B	6	151.8	151.8	6	15	
TDS-170	423.8	₩B	6	109.2	109.2	6	50	
TDS-170	423.8	EB	6	208.2	208.2	6	50	
TDS-104	424.6	EB	6	102.6	102.6	6	42	
TDS-105	424.6	₩B	8	226.4	226.4	8	85	
TDS-106	425.4	EB	6	253.8	253.8	6	54	
TDS-107	425.6	₩B	6	105.0	105	6	24	

	105	6	24		183+20	0
					183+60	<u>5</u>
			REVISION	NS		_
	DATE		DESCRIPTION		BY	S
						Ī
						Ī
,						Τ

1				
	THIS	SHEET SUPE	RSED	ES SHEET 134
TABLE OF CONCRETE BARRIER E DIFFERE	MEDIAN	CON( BARR	CRÉTE IER E	PROPOSED MEDIAN LEVATION ENCE (X)
STATION	X (IN)	STAT	ION	X (IN)
184+00	8.44	203+	20	7.53
184+40	7.78	203+	·60	6.24
184+80	5.56	204+	·00	9.30
185+20	8.66	204+	·40	7.82
185+60	7.80	204+	·80	8.11
186+00	8.71	205+	·20	6.90
186+40	9.38	205+	·60	4.51
186+80	11.47	206+	·00	2.42
187+20	8.69			
187+60	9.48			
188+00	9.79			
188+40	9.51			
188+80	6.38			
189+20	6.88			
189+60	8.38			
190+00	7.00			
190+40	7.56			

	202+80	7.04		
NEW YORI STAT	Thruway Authorit	v L	TITLE OF PROJECT 1-90 EB AND WB PAVEMENT REHABILITATION OCATION OF PROJECT MP 419.4 - 425.9	TAB 25-13  DATE: JULY 2025
м	M OTT ACDONALD	T	ITLE OF DRAWING  MISCELLANEOUS TABLES  4 OF 12	DRAWING NUMBER:

ARCHITECT, LANDSCAPE ARCHITECT, OR LAND SURVEYOR, TO ALTER AN ITEM IN ANY WAY. IF AN ITEM BEARING THE STAMP OF A LICENSED PROFESSIONAL IS ALTERED, THE ALTERING ENGINEER, ARCHITECT

IT IS A VIOLATION OF LAW FOR ANY PERSON, UNLESS THEY ARE ACTING UNDER THE DIRECTION OF A LICENSED PROFESSIONAL ENGINEER,

LANDSCAPE ARCHITECT, OR LAND SURVEYOR SHALL STAMP THE DOCUMENT AND INCLUDE THE NOTATION "ALTERED BY" FOLLOWED BY THEIR SIGNATURE, THE DATE OF SUCH ALTERATION, AND A SPECIFIC DESCRIPTION OF THE ALTERATION.

TABLE OF PROPOSED

CONCRETE MEDIAN

BARRIER ELEVATION

STATION

168+00

168+40

168+80

174+40

174+80

175+20

182+00 182+40

182+80

DIFFERENCE (X)

X ([N)

0.00

0.00

6.15

9.29

11.47

10.93

8.74

11.11

12.64

13.04

13.60

14.22

13.78

12.43

14.18

14.44

16.98

15.12

15.25

13.05

11.96

8.84

10.43

7.22

6.94

6.75

6.23

5.63

8.22

7.76

5.09

8.89

9.28

9.05

10.16

7.88

8.47

8.61

8.91

9.27

190+80

191+20

191+60

200+00

200+40

200+80

201+20

201+60

202+00

202+40

10.21

10.32

11.11

9.93

12.33

11.78

9.09

7.70

2.87

3.33

6.20

7.80

8.07

4.56

3.43

0.65

0.74

4.12

4.19

4.37

5.07 6.20

12/24

BILLITTIER Ľ.

GUIDE RAILING TABLE TEM NO. DESCRIPTION ITEM NO. 606.10 BOX BEAM GUIDE RAIL 619,1716 TEMPORARY POSITIVE BARRIER - CATEGORY 6 (PINNING REQUIRED) 606.120101 BOX BEAM END PIECE 654.5030 EXPENDABLE IMPACT ATTENUATOR, TL 3, <=2 FT OBSTRUCTION WIDTH 606.1203 BOX BEAM END ASSEMBLY, TYPE III 606.27 HPBO (MOD.) CORRUGATED BEAM GUIDE RAILING END TERMINAL (ENERGY ABSORBING) HPBO (MOD.) CORRUGATED BEAM GUIDE RAILING 1606.2701 606.2703 ANCHORAGE UNITS FOR HPBO (MOD.) CORRUGATED BEAM GUIDERAILING HPBO (MOD.) CORRUGATED BEAM MEDIAN BARRIER 606.2801 ANCHORAGE UNITS FOR HPBO (MOD.) CORRUGATED BEAM MEDIAN BARRIER 606.2802 SINGLE-SLOPE CONCRETE MEDIAN BARRIER (OPTIONAL) 606.3041 CONCRETE MEDIAN BARRIER (MODIFIED) (SEE MSD-2 FOR BARRIER DESIGN) 606.30330008 606.3061 SINGLE SLOPE CONCRETE HALF SECTION BARRIER (OPTIONAL) 606.3062 SINGLE-SLOPE CONCRETE HALF SECTION BARRIER (PRECAST) 606.57 RESETTING PRECAST CONCRETE BARRIER 606.59200125 RESETTING END TERMINALS FOR BOX BEAM GUIDE RAIL AND MEDIAN BARRIER 606.65000004 REMOVE, TRANSPORT AND STORE TEMPORARY PRECAST CONCRETE BARRIER 606.71 REMOVING AND DISPOSING CORRUGATED BEAM GUIDE RAILING 606.7101 REMOVING AND DISPOSING HEAVY POSTS BLOCKED-OUT (MOD.)CORRUGATED BEAM GUIDE RAILING 606.72 REMOVING AND DISPOSING CORRUGATED BEAM MEDIAN BARRIER 606.7201 REMOVING AND DISPOSING HEAVY POSTS BLOCKED-OUT (MOD.) CORRUGATED BEAM MEDIAN BARRIER 606.73 REMOVING AND DISPOSING BOX BEAM GUIDE RAILING 606.75 REMOVING AND DISPOSING CONCRETE BARRIER REMOVING AND DISPOSING ANCHORAGE UNITS FOR CORRUGATED BEAMGUIDE RAILING AND MEDIAN BARRIER 606,7910 606.7921 REMOVING AND DISPOSING BOX BEAM GUIDE RAILING ENERGY ABSORBING TERMINAL 606.7941 REMOVING AND DISPOSING ANCHORAGE UNITS FOR HEAVY POSTSBLOCKED OUT (MOD.) CORRUGATED BEAM GUIDE RAILING 606.7946 REMOVING AND DISPOSING ANCHORAGE UNITS FOR HEAVY POSTSBLOCKED OUT (MOD.) CORRUGATED BEAM MEDIAN BARRIER 1606.8803 TRANSITION BETWEEN BOX BEAM GUIDE RAIL AND SINGLE SLOPE HALFSECTION CONCRETE BARRIER(ONE OR TWO WAY OPERATION) 606.8901 TRANSITION: HEAVY POSTS BLOCKED OUT (MOD.) CORRUGATED GUIDERAILING TO BOX BEAM GUIDE RAILING 606.8906 TRANSITION: HEAVY POSTS BLOCKED OUT (MOD.) CORRUGATED BEAMMEDIAN BARRIER TO SINGLE SLOPE CONCRETE MEDIAN BARRIER CONCRETE MEDIAN BARRIER TRANSITION (CAST IN PLACE) 606.90000011 TRANSITION BETWEEN HALF-SECTION AND FULL-SECTION SINGLESLOPE CONCRETE BARRIER (RIGHT POCKET) 606.9004 606.7201 606. 619.1 DRAWING / DESCRIPTION CL STATION TO CL STATION SIDE OFFSET (LF) (LF) (LF) (LF) (EA) (LF) (LF) (LF) (LF) (LF) (EA) (EA) (EA) (EA) (LF) (EA) (LF) (LF) (EA) (EA) (EA) (EA) (EA) (EA) (LF) (EA) (LF) (EA) 270 GNP-1 EB 149+30 TO EB 152+00 LT 270 EB 152+00 TO EB 162+00 0 1000 1000 EB 162+00 TO EB 172+00 0 820 180 1400 GNP-2 TO GNP-3 WB 152+30 TO WB 152+60 RT 63 1 67 EB 161+80 TO EB 164+30 250 WB 163+60 TO WB 166+10 58 250 EB 172+00 TO 182+00 0 460 440 2000 100 GNP-4 TO GNP-5 EB 182+00 TO EB 192+00 0 160 840 2000 EB 192+00 TO EB 197+25 0 150 375 815 EB 198+70 TO EB 202+00 0 70 260 330 60 WK 3+00 TO WK 3+20 LT 10 1 GNP-6 TO GNP-7 WB 193+37 TO WB 196+30 60 293 268 WB 199+20 TO WB 202+00 55 280 RT WB 202+00 TO WB 203+07 55 107 107 EB 202+00 TO EB 212+00 0 535 465 1000 SUBTOTAL: 793 3 2 0 387 0 0 0 3465 2560 0 0 0 655 0 0 0 8815 0 0 100 120 ALTERED ON: 11-13-2025

# NOTES:

ALL GUIDERAIL HAS A STANDARD POST SPACING, RESULTING IN A PAYMENT FACTOR OF 1.00.

SIGNATURE: STAMP:

IT IS A VIOLATION OF LAW FOR ANY PERSON, UNLESS THEY ARE ACTING UNDER THE DIRECTION OF A LICENSED PROFESSIONAL ENGINEER, ARCHITECT, LANDSCAPE ARCHITECT, OR LAND SURVEYOR, TO ALTER AN ITEM IN ANY WAY IF AN ITEM BEARING THE STAMP OF A LICENSED. PROFESSIONAL IS ALTERED, THE ALTERING ENGINEER, ARCHITECT LANDSCAPE ARCHITECT, OR LAND SURVEYOR SHALL STAMP THE DOCUMENT AND INCLUDE THE NOTATION "ALTERED BY" FOLLOWED BY THEIR SIGNATURE, THE DATE OF SUCH ALTERATION, AND A SPECIFIC DESCRIPTION OF THE ALTERATION.

	DATE	DESCRIPTION	BY	SYM.
,				

REVISIONS

NEW YORK STATE	Thruway Authority

F PROJECT 1-90 EB AND WB PAVEMENT REHABILITATION MP 419.4 - 425.9

MISCELLANEOUS TABLES

**THIS SHEET SUPERSEDES SHEET 139** 

MST-9

TAB 25-13

JULY 2025

13/24

9 OF 12

<u>,                                     </u>	140-A1	
•	\ /	
	<b>₹371</b>	

												GL	IDE RAIL	ING TAB	LE (CON	(INUED)																		
DRAWING / DESCRIPTION	CL STATION TO CL STATION	SIDE	OFFSET	606.10	606.120101	606.1203	606.27	606.2701	606.2703	606.2801	606.2802	606,3041	606.30330008	606.3061	606.3062	606.57	606.59200125	606.71	606.7101	606.72	606.7201	606.73	606.75	606.7910	606.7921	606.7941	606.7946	606.8803	606.8901	9068*909	606.90000011	606.9004	619.1716	654.5030
	FR 212.00 TO FR 222.00			(LF)	(EA)	(EA)	(EA)	(EA)	(EA)	(LF)	(EA)		(LF)	(LF)	(LF)	(LF)	(EA)	(LF)	(LF)	(LF)	(LF)	(LF)	(LF)	(EA)	(EA)	(EA)	(EA)	(EA)	(E A)	(EA)	(LF)	(EA)	(LF)	(EA)
	EB 212+00 TO EB 222+00							1.40				1000							1.40				1000											<del></del>
	EB 213+02 TO EB 214+50 EB 214+50 TO EB 222+00		65					148 750	1									750	148							1								<u> </u>
GNP-8 TO GNP 9	WB 215+17 TO 222+00	RT	66	683	1			130										683																
0NI 0 10 0NI 3	EB 222+00 TO EB 230+58			603	1							858						003					858									2	60	<del></del>
	EB 222+00 TO EB 230+20	$\vdash$						920				636						920					636						,			2	- 60	$\vdash$
	WB 222+00 TO 229+80	RT	55	700				820										820											1					<del></del>
			55	780								1,,,,						780					1121											<del>                                     </del>
CND 10 TO CND 11	EB 240+89 TO EB 252+00			05.5	•							1111						500	470				1121			,							60	<u> </u>
GNP-10 TO GNP-11	EB 241+50 TO EB 251+05		55	955	1			0.45										500	430															<u> </u>
	WB 241+30 TO WB 251+00	-						945	1			1150						815	130				1150			1								<u> </u>
CND 10 TO CND 17	EB 252+00 TO EB 263+50	$\vdash$										1150				500							1150											<u> </u>
GNP-12 TO GNP-13	EB 263+50 TO EB 268+50	$\vdash$										750				500							75.0											<u> </u>
	EB 268+50 TO EB 272+00	$\vdash$										350											350											<del></del>
	EB 272+00 TO EB 282+00											929.4											1000								70.6			<del></del>
	EB 282+00 TO EB 287+50											550											550											<u> </u>
	EB 287+50 TO EB 291+50															400																		<u> </u>
GNP-14 TO GNP-15	EB 291+50 TO EB 292+00	$\vdash$										50											50											<u> </u>
	EB 285+20 TO EB 288+72			352		1																												<u> </u>
	EB 288+72 TO EB 290+08														84								136					1						<u> </u>
	WB 285+20 TO WB 285+50	$\vdash$															1																	<u> </u>
	WB 289+05 TO WB 292+00											182			103								295									1		<u> </u>
	EB 292+00 TO EB 302+00											1000											1000											<u> </u>
	WB 292+00 TO WB 292+85	RT	75 TO 82									30										55	70					1						<u> </u>
	WF 12+00 TO WF 15+00	RT	7.5	300														300																<u> </u>
	EB 302+00 TO EB 308+76	LT	0 TO 2									605.4											886								70.6		60	<u> </u>
GNP-16 TO GNP-17	EB 311+22 TO EB 312+00	LT										78											78										60	<u> </u>
	WH 16+10 TO WH 16+30	RT	10			1																												<u> </u>
	WB 305+48 TO WB 307+85	RT	70	237														237																<u> </u>
	WB 311+35 TO WB 312+00	RT	68	65														65																<u> </u>
	WF 15+00 TO WF 18+31	RT	8-10	331														331																
		SUB1	TOTAL:	3703	2	2	0	2663	2	0	0	7893.8	0	0	187	900	1	5281	708	0	0	55	8544	0	0	3	0	2	1	0	141.2	3	240	0

CKEN		
ز	ALTERED ON:	AFFIXED ON: 11-13-2025
E K	SIGNATURE: STAMP:	SIGNATURE: STAMP:
. BILLII IIEK		ANTE OF NEW YOU
<u>۲</u>		ST. BILLITY AND THE
SUPERVISOR:		五年 6 年
		06T259 CH
DESIGN		PROFESSIONAL

IT IS A VIOLATION OF LAW FOR ANY PERSON, UNLESS THEY ARE ACTING UNDER THE DIRECTION OF A LICENSED PROFESSIONAL ENGINEER, ARCHITECT, LANDSCAPE ARCHITECT, OR LAND SURVEYOR, TO ALTER AN ITEM IN ANY WAY. IF AN ITEM BEARING THE STAMP OF A LICENSED PROFESSIONAL IS ALTERED, THE ALTERING ENGINEER, ARCHITECT, LANDSCAPE ARCHITECT, OR LAND SURVEYOR SHALL STAMP THE DOCUMENT AND INCLUDE THE NOTATION "ALTERED BY" FOLLOWED BY THEIR SIGNATURE, THE DATE OF SUCH ALTERATION, AND A SPECIFIC DESCRIPTION OF THE ALTERATION.

		REVISIONS			
	DATE	DESCRIPTION	BY	SYM.	
١T					
RE,					
				1	

NEW YORK STATE	Thruway Authority

TLE OF PROJECT

1-90 EB AND WB

PAVEMENT REHABILITATION

MP 419.4 - 425.9

JULY 2025 MISCELLANEOUS TABLES 10 OF 12

MST-10

TAB 25-13

14/24

FILE NAME = DATE/TIME = 1

EET SUPERSEDES SHEET 141	141-A1
	<b>X3/</b> 1

												GU	IDE RAIL	ING TAE	LE (CON	(INUED																		
DRAWING / DESCRIPTION	CL STATION TO CL STATION	SIDE	OFFSE1	606.10	606.120101	606.1203	606.27	606.2701	606.2703	606.2801	606.2802	606.3041	606.30330008	606,3061	606.3062	606.57	606.59200125	606.71	606.7101	606.72	606.7201	606.73	606.75	606.7910	606.7921	606.7941	606.7946	606.8803	606.8901	906*809	606.90000011	606.9004	619.1716	654,5030
				(LF)	(EA)	(EA)	(EA)	(EA)	(EA)	(LF)	(EA)	(LF)	(LF)	(LF)	(LF)	(LF)	(EA)	(LF)	(LF)	(LF)	(LF)	(LF)	(LF)	(EA)	(EA)	(EA)	(EA)	(EA)	(EA)	(EA)	(LF)	(LF)	(LF)	(EA)
	EB 312+00 TO EB 322+00	LT	0									1000											1000											
	EB 312+25 TO EB 322+00	RT	55-65	975														975																
	WB 312+00 TO WB 322+00	RT	57-68	1000														1000																
GNP-18 TO GNP-19	EB 322+00 TO EB 332+00	LT	0-2									940		120									1220											
011 10 10 011 13	EB 322+00 TO EB 324+80	RT	55-58	228											40			200				180	90					2						
	EB 325+80 TO EB 331+32	RT	55-58	552														552																
	WB 322+00 TO WB 326+00	RT	56	228											40			220				180	100					2						
	WB 326+00 TO WB 332+00	RT	56 TO 58	600														600																
	EB 332+00 TO EB 342+00	LT	0									1000											1000											
	WB 332+00 TO WB 334+13	RT	58	163		1												100	113															
GNP-20 TO GNP-21	EB 342+00 TO EB 352+00	LT	0-3									900		200									1215											
	EB 342+60 TO EB 348+60	RT	58-61	460		1									230							105	105					1						
	WB 345+35 TO WB 352+20	RT	58-61	440		1									193							545	105					1						
	EB 352+00 TO EB 362+00	LT	0-2									929.4											1300								70.6			
	EB 356+65 TO EB 356+85	RT	68														1																	
GNP-22 TO GNP-23	EB 362+00 TO EB 372+00	LT	0									1000											1000											
	EB 370+50 TO EB 372+00	RT	68	150		1																												
	EB 372+00 TO EB 382+00	LT	0-2									920		160									1310											
	EB 372+00 TO EB 375+40	RT	62-68	190											88							140	140					1						
GNP-24 TO GNP-25	WB 374+35 TO WB 379+50	RT	62-90	320		1									100							515	135					1						
	EB 382+00 TO EB 392+00	LT	0									1000											1000											
	EB 392+00 TO EB 402+00	LT	0									1000											1000											
	WB 401+80 TO WB 402+00	RT	62-68														1																	
GNP-26 TO GNP-27	WB 407+90T0 WB 408+10	RT	69														1																	
	EB 402+00 TO EB 412+00	LT	0									1000											1000											
	EB 412+00 TO EB 416+50	LT	0									450											450											
GNP-28 TO GNP-29	EB 415+80 TO EB 416+50	RT	60														1																	
	EB 426+50 TO EB 432+00	LT	0-6							500	2										500						2							
	WB 431+30	RT	60														1																	
	MC 20+50 TO MC 23+00	RT	22					250	1										250															
	1	SL	1	: 5306	0	5	0	250	1	500	2	10139.4	0	480	691	0	5	3647	363	0	500	1665	12170	0	0	0	2	8	0	0	70.6	0	0	0
				1	1	I		l	I	l	I	I	l	L	l .			I					1			l	<u> </u>	I	1					

CREN		
E	ALTERED ON:	AFFIXED ON: 11-13-2025
DESIGN SUPERVISOR: F. BILLITIER &	SIGNATURE: STAMP:	SIGNATURE: STAMP:  OF NEW PORTS

IT IS A VIOLATION OF LAW FOR ANY PERSON, UNLESS THEY ARE ACTING UNDER THE DIRECTION OF A LICENSED PROFESSIONAL ENGINEER, ARCHITECT, LANDSCAPE ARCHITECT, OR LAND SURVEYOR, TO ALTER AN ITEM IN ANY WAY. IF AN ITEM BEARING THE STAMP OF A LICENSED PROFESSIONAL IS ALTERED, THE ALTERING ENGINEER, ARCHITECT, LANDSCAPE ARCHITECT, OR LAND SURVEYOR SHALL STAMP THE DOCUMENT AND INCLUDE THE NOTATION "ALTERED BY" FOLLOWED BY THEIR SIGNATURE, THE DATE OF SUCH ALTERATION, AND A SPECIFIC DESCRIPTION OF THE ALTERATION.

		REVISIONS			
	DATE	DESCRIPTION	BY	SYM.	
IT					
RE,					

NEW YORK STATE	Thruway Authority

TLE OF PROJECT

1-90 EB AND WB

PAVEMENT REHABILITATION

MP 419.4 - 425.9

TAB 25-13 JULY 2025 MISCELLANEOUS TABLES
11 OF 12

MST-11

15/24

FILE NAME = DATE/TIME = 1

F. BILLITTIER	
CHECKED BY:	

DRAWING / DESCRIPTION

GNP-30 TO GNP-31

GNP-32 TO GNP-33

GNP-36

GNP-37

GNP-38

GNP-39

GNP-40

GNP-41

GNP-42

GNP-44

GNP-45

GNP-46

GNP-47

GNP-49

z.

ALTERED ON:

BILLITTIER & ч.

11-13-2025

9

14

INFORMATION REGARDING LOCATION AND STORAGE METHOD.

2058

5358

0

2530

3030

0

2

6457

27955.2 2560

0

0

480

440

1318

0

900

3

11

# NOTES:

1

1

1

6

15

2

606.1203

1

606.1

440

50

520

420

581

820

500

400

150

850

4811

14613

1

RT 56-62

LT 17-23

RT 16-20

LT 2-12

RT 18-22

LT 18-22

RT 56-67

20

| LT | 0-5

RT

RT 20

LT | 0

LT 0

RT 9-16

RT 9-14

LT 0

LT 0

LT 0

LT 0

LT 20-26

RT 20-26

LT 25

RT 22 RT 34

22 LT 21-27

RT | 18-25

RT 22-25

SUBTOTAL:

LT

LT 27

RT

0

10 LT 0

56

CL STATION TO CL STATION SIDE OFFSET

EB 432+00 TO EB 442+00 LT 3-10

EB 434+60 TO EB 441+40

WB 438+40 TO WB 441+40

MC 24+95 TO MC 30+00

MC 23+00 TO MC 30+30

EB 442+00 TO EB 452+00

MB 4+80 TO MB 10+00

MB 5+80 TO MB 10+00

EB 452+00 TO EB 462+00

WB 452+33 TO WB 461+56

EB 462+00 TO EB 462+90

WC 19+10 TO WC 19+30

WD 10+40 TO WD 10+60

WC 15+15 TO WD 11+75

WF 00+34 TO WF 8+61

WF 6+19 TO WF 12+00

WE 01+25 TO WE 9+45

WA 7+25 TO WB 5+80

WG 00+25 TO WH 6+45

LC 8+50 TO LD 10+13

LF 1+40 TO LE 9+40

LB 5+88 TO LA 12+05

LA 13+60

LG 2+70 to LH 8+90

MA 8+50 TO MA 13+50

MA 9+50 TO MA 13+50

MB 16+78

MB 17+40

MA 22+60

MA 18+94

MC 41+50 TO MC 44+00

MC 35+50 TO MC 44+00

MC 44+00

MC 44+00 TO MC 44+80

606.27

1

1

455

730

873

(LF) (EA) (EA) (EA) (EA)

606.2703

650

900

880

100

CONTRACTOR IS TO REMOVE AND STORE 10,000 LF
OF TEMPRARY CONCRETE BARRIER UNDER ITEM 606.65000004
TO THE NYSTA MAINTENANCE AREA. SEE MSD-4 FOR MORE
INFORMATION DECARDING LOCATION AND STORAGE METHOD

IT IS A VIOLATION OF LAW FOR ANY PERSON, UNLESS THEY ARE ACTING	
UNDER THE DIRECTION OF A LICENSED PROFESSIONAL ENGINEER,	Г
ARCHITECT, LANDSCAPE ARCHITECT, OR LAND SURVEYOR, TO ALTER AN	⊨
ITEM IN ANY WAY. IF AN ITEM BEARING THE STAMP OF A LICENSED	L
PROFESSIONAL IS ALTERED, THE ALTERING ENGINEER, ARCHITECT,	Н
LANDSCAPE ARCHITECT, OR LAND SURVEYOR SHALL STAMP THE DOCUMENT	L
AND INCLUDE THE NOTATION "ALTERED BY" FOLLOWED BY THEIR SIGNATURE,	Н
THE DATE OF SUCH ALTERATION, AND A SPECIFIC DESCRIPTION OF THE	L
ALTERATION.	Г

		REVISIONS								
	DATE	DESCRIPTION	BY	SYM.						
IT RE,										

REVISIONS

GUIDE RAILING TABLE (CONTINUED)

606,3061

606.3041

600

135

220

615

827

930

620

560

855

490

605

606.3062

240

200

606.57

400

730

495

395

700

556

770

475

375

200

850

55 6001

15584

211

1282

2025

2025

1510

2010

1344 6360

35889

3064

1

105

106

1035

990

110

150

NEW YORK STATE	Thruway Authority

606.7910

2

1

1

606.7941

606.75 SEE NOTE

580

225

606.7201

1250

605

300

117 53

72

250

615

827

930

620

560

855

490

605

1

11

12

4

0

3

0

2

12

2

4

5

0

311.8

0

0

360

5

OF PROJECT 1-90 EB AND WB PAVEMENT REHABILITATION MP 419.4 - 425.9

MISCELLANEOUS TABLES

THIS SHEET SUPERSEDES SHEET 142

606.9004

2

1

1

1

1

JULY 2025

TAB 25-13

16/24

12 OF 12	MST-12
	16/24

1

1

1

2

F1LE DATE/

F. BILLITTIER &


X (VARIES) \_ ½X \_ EXISTING TEMPORARY CONCRETE BARRIER OR PROPOSED CONCRETE BARRIER ITEM 209.2301 SEDIMENT FILTER LOG-TEMPORARY 12"

DRAINAGE STRUCTURE INLET PROTECTION - TEMPORARY (SEDIMENT FILTER LOG VARIATION)


SCALE: 1" = 5'

NOTES:

1. TO BE ESTABLISHED AND MAINTAINED IN EACH STAGE ONCE MEDIAN EXCAVATION IS STARTED AND THROUGH THE TOP COURSE PLACEMENT.

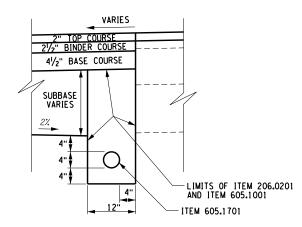


UNDERDRAIN SCALE: 1/2" = 1'

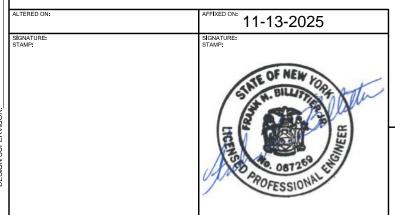

IT IS A VIOLATION OF LAW FOR ANY PERSON, UNLESS THEY ARE ACTING UNDER THE DIRECTION OF A LICENSED PROFESSIONAL ENGINEER, ARCHITECT, LANDSCAPE ARCHITECT, OR LAND SURVEYOR, TO ALTER AN ITEM IN ANY WAY, IF AN ITEM BEARING THE STAMP OF A LICENSED PROFESSIONAL IS ALTERED, THE ALTERING ENGINEER, ARCHITECT, LANDSCAPE ARCHITECT, OR LAND SURVEYOR SHALL STAMP THE DOCUMENT AND INCLUDE THE NOTATION "ALTERED BY" FOLLOWED BY THEIR SIGNATURE, THE DATE OF SUCH ALTERATION, AND A SPECIFIC DESCRIPTION OF THE ALTERATION.

	REVISIONS			NEW Thereses	I-90 EB AND WB	
DATE	DESCRIPTION	BY	SYM	YORK   III GWGY	PAVEMENT REHABILITATION LOCATION OF PROJECT	
				Authority	MP 419.4 - 425.9	
					TITLE OF DRAWING	
				M M	MISCELLANEOUS DETAILS 1 OF 8	

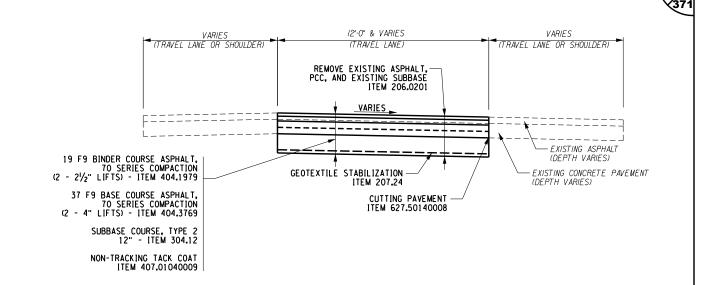

THIS SHEET SUPERSEDES SHEET 143

FULL DEPTH PAVEMENT REPAIR DETAIL

TAB 25-13


JULY 2025

MSD-1

ALTERED ON:

BILLITTIER & Ľ.


FILE DATE

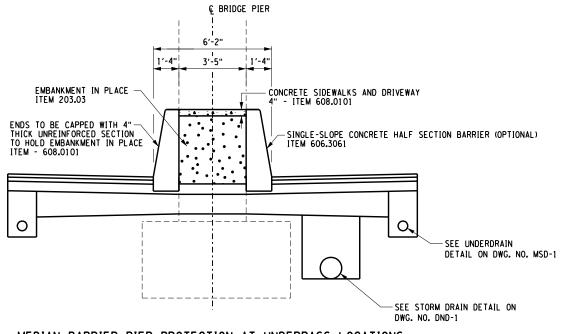

# MEDIAN BARRIER PIER PROTECTION AT UNDERPASS LOCATIONS

SCALE: 1" = 5'

(LOCATIONS INCLUDE GEORGE URBAN BLVD. UNDERPASS, GENESSE ST. UNDERPASS, AND NY 33 UNDERPASS)

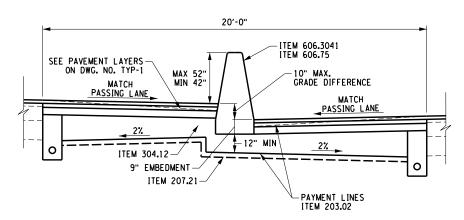


#### MEDIAN BARRIER DETAIL

11-13-2025

SCALE: 1" = 5' (SEE MST-9 FOR LOCATIONS) (NORMAL CROWN SECTION)


### NOTES:

- 1. IF CONTRACTOR CHOOSES TO UTILIZE "CAST IN PLACE" METHOD FOR SINGLE SLOPE CONCRETE MEDIAN BARRIER (ITEM 606.3041 AND 606.3061), NO HORIZONTAL JOINT WILL BE ALLOWED TO BE LOCATED BETWEEN THE TOP OF BARRIER TO THE BOTTOM OF 9" EMBEDMENT. THEREFORE, THE CROSS SECTION FROM TOP OF THE BARRIER TO BOTTOM OF 9" EMBEDMENT MUST BE CAST AS ONE MONOLITHIC POUR.
- 2. IF CONTRACTOR PROPOSES TO UTILIZE A "FOOTER", THE "FOOTER" SHALL BE BELOW THE BOTTOM OF THE 9" EMBEDMENT.
- 3. IF CONTRACTOR CHOOSES TO UTILIZE "CAST IN PLACE" METHOD FOR SINGLE SLOPE CONCRETE MEDIAN BARRIER MODIFIED (ITEM 606.30330008), A HORIZONTAL JOINT MAY BE CONSIDERED BY THE NYSTA WITH COMPLIANCE TO NYSDOT STANDARD SPECIFICATION
- 4. CONTRACTOR IS TO PROVIDE MODIFIED CONCRETE BARRIER DETAIL FOR APPROVAL BY NYSTA PRIOR TO FABRICATION.

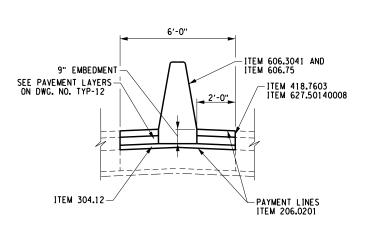

# RAMP MEDIAN BARRIER DETAIL


SCALE: 1" = 5' (SEE MST-9 FOR LOCATIONS)

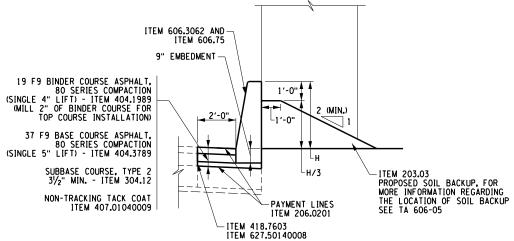

#### PRECAST PIER PROTECTION BARRIER DETAIL

THIS SHEET SUPERSEDES SHEET 144

SCALE: 1" = 5' (SEE MST-9 FOR LOCATIONS)

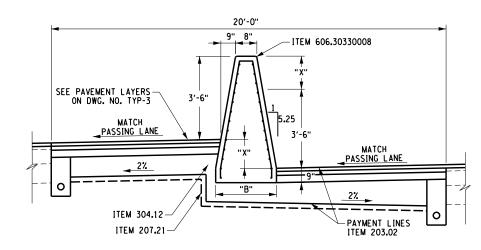

#### MODIFIED CONCRETE MEDIAN BARRIER DETAIL

SCALE: 1" = 5' (SEE MST-4 FOR LOCATIONS) (STA. 168+00 TO STA. 196+50 STA. 199+60 TO STA. 206+85)

IT IS A VIOLATION OF LAW FOR ANY PERSON, UNLESS THEY ARE ACTING
UNDER THE DIRECTION OF A LICENSED PROFESSIONAL ENGINEER,
ARCHITECT, LANDSCAPE ARCHITECT, OR LAND SURVEYOR, TO ALTER AN
ITEM IN ANY WAY. IF AN ITEM BEARING THE STAMP OF A LICENSED
PROFESSIONAL IS ALTERED, THE ALTERING ENGINEER, ARCHITECT,
LANDSCAPE ARCHITECT, OR LAND SURVEYOR SHALL STAMP THE DOCUMENT
AND INCLUDE THE NOTATION "ALTERED BY" FOLLOWED BY THEIR SIGNATURE,
THE DATE OF SUCH ALTERATION, AND A SPECIFIC DESCRIPTION OF THE
ALTERATION.

REVISIONS				NEW Thruway	I –90 EB AND WB	CONTRACT NUMBER:
DATE	DESCRIPTION	BY	SYM.	1 IURN I I	PAVEMENT REHABILITATION  LOCATION OF PROJECT	TAB 25-13
				STATE   Authority		DATE: JULY 2025
					TITLE OF DRAWING	30L1 2023
$\top$				M M	MISCELLANEOUS DETAILS	DRAWING NUMBER:
				MOTT MACDONALD	2 OF 8	MSD-2

